

# CERTIFICATE OF LOCATION OF GOVERNMENT CORNER

County of Anoka

State of Minnesota



Witness Corner of Sec. 6 Township 32 Range 24  
 (on north line of section)

On the 3rd day of May, 1966, the described corner was evidenced by area resurvey

and to perpetuate the location of said corner, at the exact location thereof, a permanent marker was placed consisting of a cast iron monument with a sign and post on the south side

AND on the     day of January, 2011, said permanent marker was found up 0.1'± and the ties were updated

Updated reference ties are as shown below.

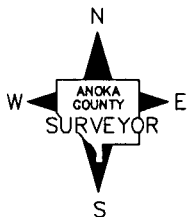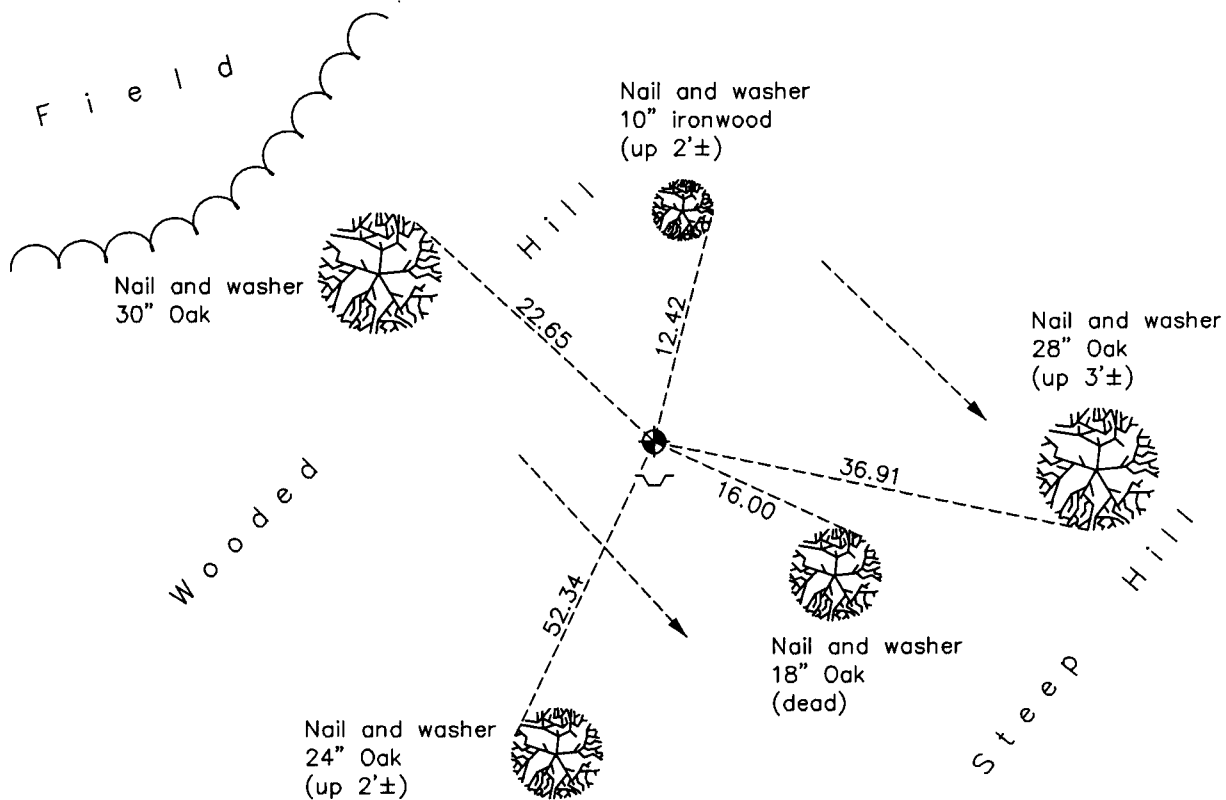

Revision Date

4/05/11

N.A.D. 1983 Coordinates  
(1996 Adjustment)

County Project Coordinates	
Northing	196090.1365
Easting	470916.4164
Date	12/15/00

I hereby certify that this United States public land survey monument record is correct and complete to the best of my knowledge and belief.

*Larry D. Hoium* Date 4/05/11

Larry D. Hoium, Anoka County Surveyor

Minnesota License Number 18165

# HISTORY OF GOVERNMENT CORNER

Page No. 9C

County of Anoka

State of Minnesota

Witness Corner of Sec. 6 Township 32 Range 24  
(on north line of section)

## **CORNER HISTORY:**

May 3, 1966 - Set cast iron monument flush with the surface using area resurvey.

July 3, 1968 - Found cast iron monument and updated ties.

August 3, 1971 - Found cast iron monument and updated ties.

July 16, 1975 - Found cast iron monument and updated ties.

July 14, 1978 - Found cast iron monument and updated ties.

August 20, 1984 - Found cast iron monument and updated ties.

July 23, 1987 - Found cast iron monument and updated ties.

June 16, 1992 - Found cast iron monument and updated ties.

December 15, 2000 - Found cast iron monument with a sign and post on the south side and established NAD 1983 (1996 Adjustment) Anoka County Project Coordinates by Static GPS methods. Updated ties.

January 2011 - Found cast iron monument up 0.1'± with a sign and post on the south side and updated ties.