

CERTIFICATE OF LOCATION OF GOVERNMENT CORNER

County of Anoka

State of Minnesota



North 1/4 Corner of Sec. 17 Township 32 Range 24

On the 28th day of June, 1973, the described corner was evidenced by area resurvey

and to perpetuate the location of said corner, at the exact location thereof, a permanent marker was placed consisting of a red and white 2" iron pipe up 1'±

AND on the 27th day of October, 2010, said permanent marker was found leaning. Pipe was straightened. On 3/01/11 GPS coordinates were checked, ties updated and sign and post set south.

Updated reference ties are as shown below.

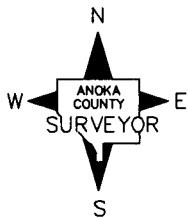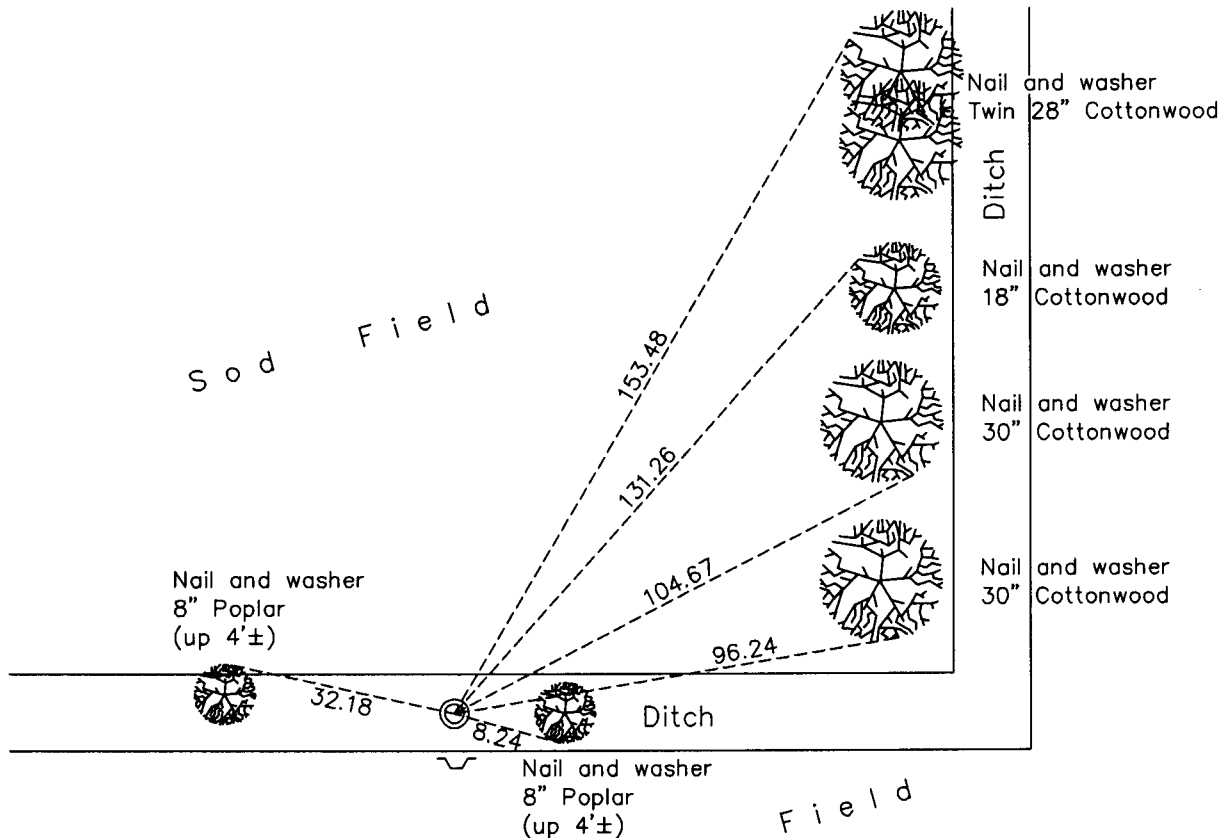

Revision Date
4/22/11

N.A.D. 1983 Coordinates
(1996 Adjustment)

County Project Coordinates	
Northing	185625.3993
Easting	476759.1495
Date	1/23/01

I hereby certify that this United States public land survey monument record is correct and complete to the best of my knowledge and belief.

Larry D. Hoium Date 4/22/11

Larry D. Hoium, Anoka County Surveyor
Minnesota License Number 18165

HISTORY OF GOVERNMENT CORNER

Page No. 45A

County of Anoka

State of Minnesota

North 1/4 Corner of Sec. 17 Township 32 Range 24

CORNER HISTORY:

June 28, 1973 - Replaced found iron pipe with a red and white iron pipe with sign attached and verified location of corner using area resurvey. Established ties to monument.

May 28, 1976 - Found red and white iron pipe and updated ties.

May 14, 1979 - Found red and white iron pipe but found all ties gone. Established new ties to monument.

June 28, 1982 - Found red and white iron pipe and updated ties.

June 5, 1985 - Found red and white iron pipe and updated ties.

August 8, 1988 - Found red and white iron pipe and updated ties.

July 15, 1993 - Found red and white iron pipe and updated ties.

January 23, 2001 - Found red and white iron pipe and established NAD 1983 (1996 Adjustment) Anoka County Project Coordinates by Static GPS methods.

October 27, 2010 - Found 2" red and white iron pipe up 1' with saw marks in pipe north, south, east and west. Iron pipe was found leaning northeast. Straightened iron pipe and updated ties. Position was GPS verified at a later date.

March 1, 2011 - Found 2" red and white iron pipe and verified position by VRS GPS methods. Updated ties and set sign and post 2'± south of monument.