

# CERTIFICATE OF LOCATION OF GOVERNMENT CORNER

County of Anoka

State of Minnesota



## East 1/4 Corner of Sec. 18 Township 32 Range 24

On the 12th day of July, 1963, the described corner was evidenced by an old rotted post from N.C. Hoium's ties

and to perpetuate the location of said corner, at the exact location thereof, a permanent marker was placed consisting of a red and white 2" square steel Telspar monument

AND on the 2nd day of November, 2010, said permanent marker was found and the ties were updated. A sign, facing south, was attached to monument.

Updated reference ties are as shown below.

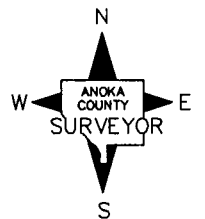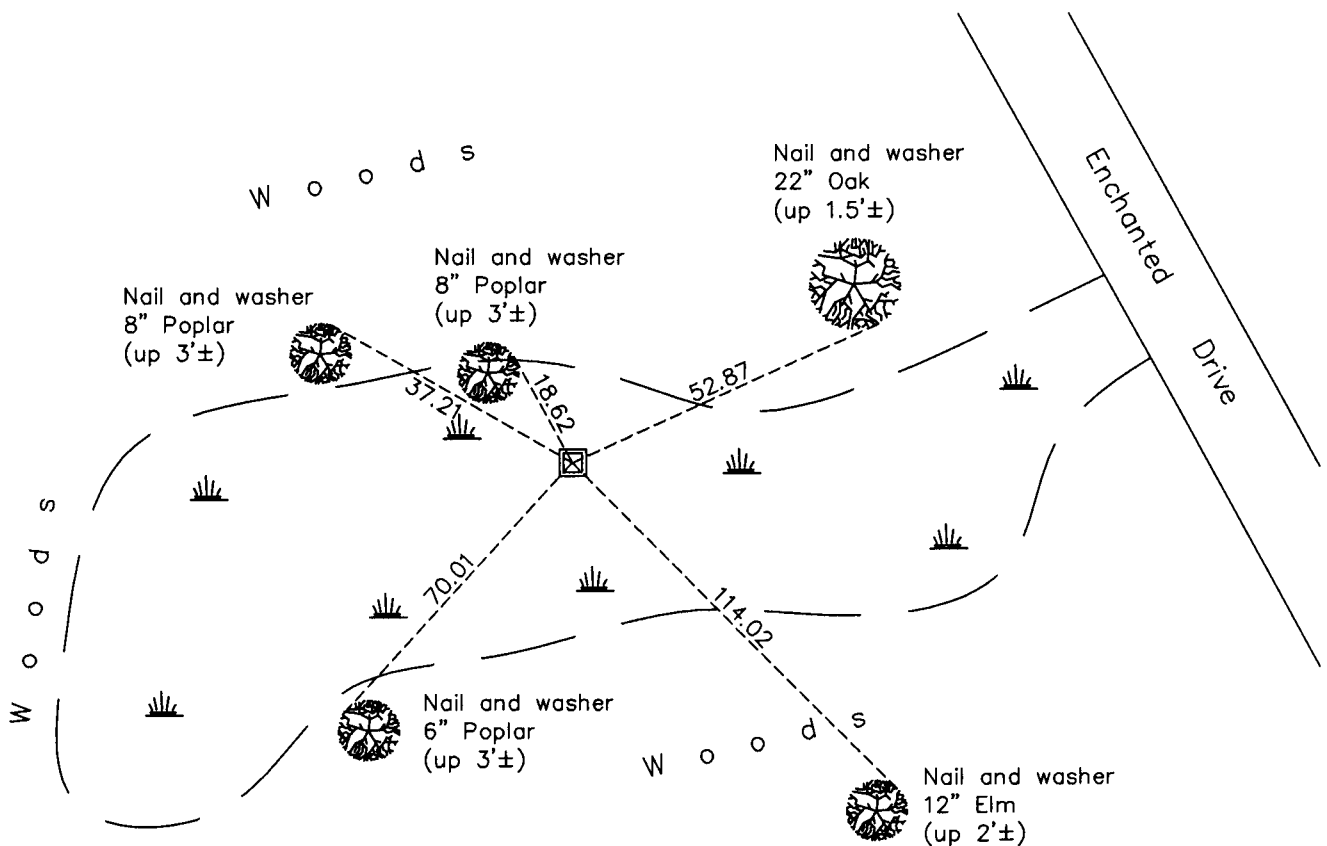

Revision Date

4/27/11

N.A.D. 1983 Coordinates  
(1996 Adjustment)

County Project Coordinates	
Northing	183041.2743
Easting	474144.0017
Date	11/07/01

I hereby certify that this United States public land survey monument record is correct and complete to the best of my knowledge and belief.

*Larry D. Hoium* Date 4/27/11

Larry D. Hoium, Anoka County Surveyor

Minnesota License Number 18165

# HISTORY OF GOVERNMENT CORNER

Page No. 50

County of Anoka

State of Minnesota

## East 1/4 Corner of Sec. 18 Township 32 Range 24

### **CORNER HISTORY:**

July 12, 1963 - Found old rotted fence post fitting N.C. Hoium ties well. Replaced fence post with 1" X 8' iron pipe up 3'± with painted 6" red and white bands. Established ties to monument.

August 26, 1964 - Found red and white iron pipe and updated ties.

July 10, 1968 - Found red and white iron pipe and updated ties.

July 7, 1972 - Found red and white iron pipe and updated ties.

February 15, 1978 - Found red and white iron pipe and replaced all nails and washers due to overgrowth of tie trees.

June 4, 1979 - Found red and white iron pipe and updated ties.

June 23, 1982 - Found red and white iron pipe and updated ties.

August 8, 1988 - Found red and white iron pipe and updated ties.

January 10, 1995 - Replaced 1" red and white iron pipe with a red and white 2" square steel Telspar monument and updated ties.

November 7, 2001 - Found red and white Telspar monument and established NAD 1983 ( 1996 Adjustment) Anoka County Project Coordinates by Static GPS methods. Updated ties.

November 2, 2010 - Found red and white Telspar monument and updated ties. Attached sign to Telspar monument facing south.