CERTIFICATE OF LOCATION OF GOVERNMENT CORNER

County of Anoka

State of Minnesota


Center Corner of Sec. 15 Township 32 Range 24

I hereby certify that on the <u>8th</u> day of <u>February</u>, <u>1963</u>, I found the described corner which was evidenced by <u>area resurvey</u>

and I further certify that to perpetuate the location of said corner, I did, at the exact location thereof, place a permanent marker consisting of <u>a cast iron monument</u>

which reference or witness monuments are located in the manner following:



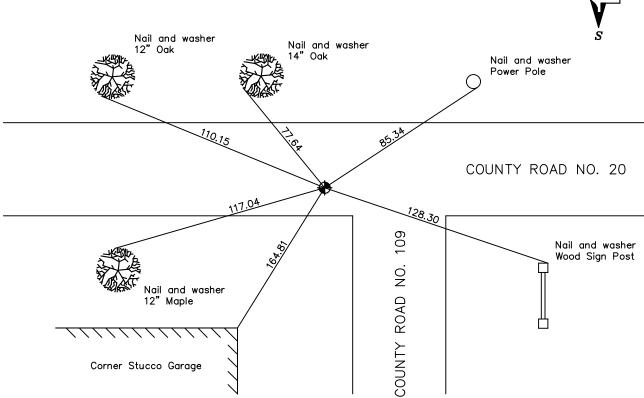

Revised date

N.A.D. 1983 Co-ordinates

	County Project Co-ordinates	State Plane Co-ordinate
	Northing 182945.6045	Y
	Easting 487257.4031	x
	Date	8/4/00
		- / · /