

# CERTIFICATE OF LOCATION OF GOVERNMENT CORNER

County of Anoka

State of Minnesota



## South 1/4 Corner of Sec. 24 Township 32 Range 24

On the 31st day of July, 1962, the described corner was evidenced by area resurvey

and to perpetuate the location of said corner, at the exact location thereof, a permanent marker was placed consisting of a cast iron monument

AND on the 31st day of January, 2011, said permanent marker was found and the ties were updated. On February 16, 2011 a sign and post was set 1' north of monument.

Updated reference ties are as shown below.

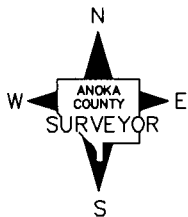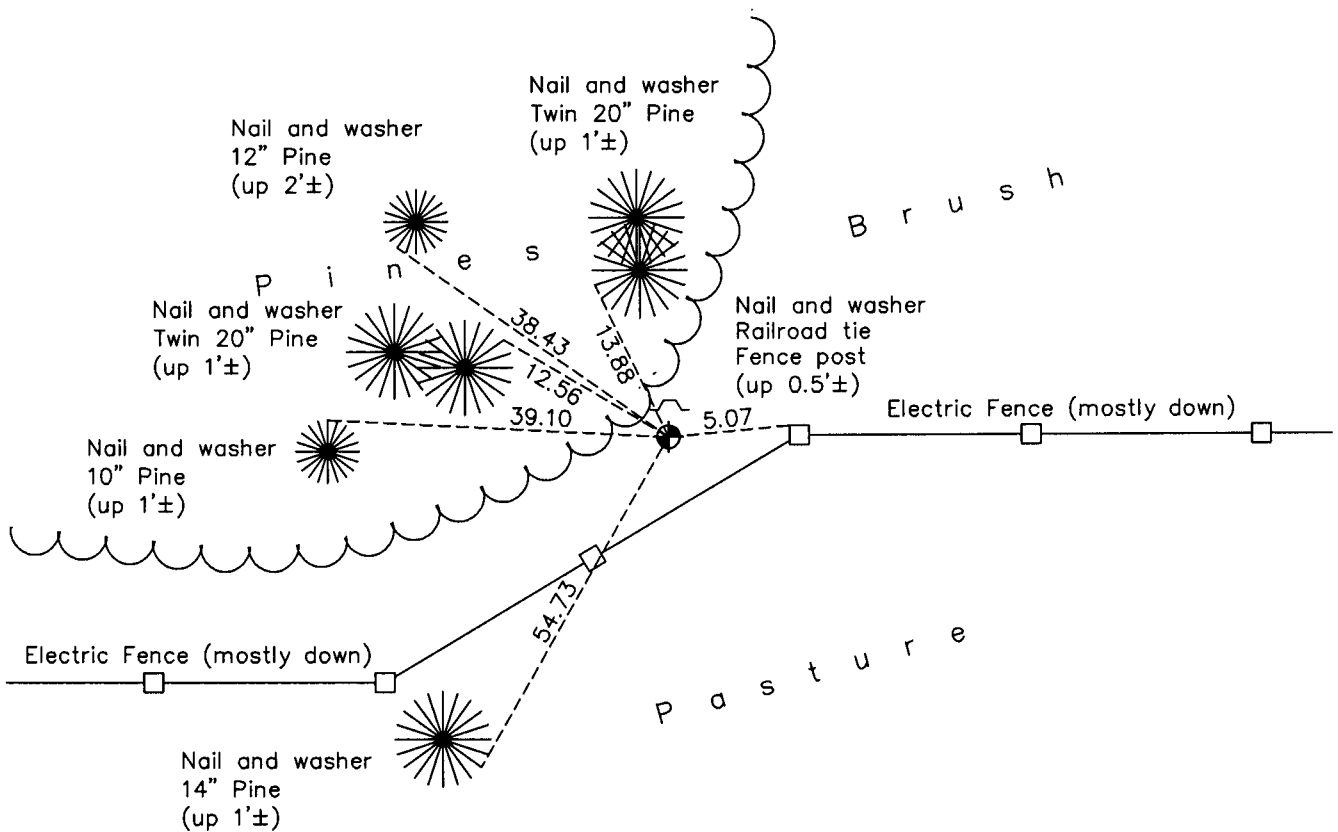

Revision Date  
5/16/11

N.A.D. 1983 Coordinates  
(1996 Adjustment)

County Project Coordinates	
Northing	<u>174844.1071</u>
Easting	<u>497720.0313</u>
Date	<u>10/24/00</u>

I hereby certify that this United States public land survey monument record is correct and complete to the best of my knowledge and belief.

*Larry D. Hoium* Date 5/16/11

\_\_\_\_\_  
Larry D. Hoium, Anoka County Surveyor

Minnesota License Number 18165

# HISTORY OF GOVERNMENT CORNER

County of Anoka

State of Minnesota

## South 1/4 Corner of Sec. 24 Township 32 Range 24

### **CORNER HISTORY:**

July 31, 1962 - Set cast iron monument up 0.2' using area resurvey and established ties to monument.

August 20, 1964 - Found cast iron monument and updated ties.

July 29, 1968 - Found cast iron monument and updated ties.

July 6, 1972 - Found cast iron monument and updated ties.

June 8, 1976 - Found cast iron monument and updated ties.

June 11, 1979 - Found cast iron monument and updated ties.

July 6, 1982 - Found cast iron monument and updated ties.

June 10, 1985 - Found cast iron monument and updated ties.

August 4, 1988 - Found cast iron monument and updated ties.

July 26, 1993 - Found cast iron monument and updated ties.

January 31, 2011 - Found cast iron monument and updated ties.

February 16, 2011 - Set sign and post 1' north of cast iron monument.