

CERTIFICATE OF LOCATION OF GOVERNMENT CORNER

County of Anoka

State of Minnesota


North 1/16 Corner of Sec. 27 Township 32 Range 24

North Line of NE 1/4

I hereby certify that on the 4th day of October, 1968, I found the described corner which was evidenced by a 1-1/2" iron pipe

and I further certify that to perpetuate the location of said corner, I did, at the exact location thereof, place a permanent marker consisting of a 1-1/2" iron pipe with sign and post on the north side

which reference or witness monuments are located in the manner following:

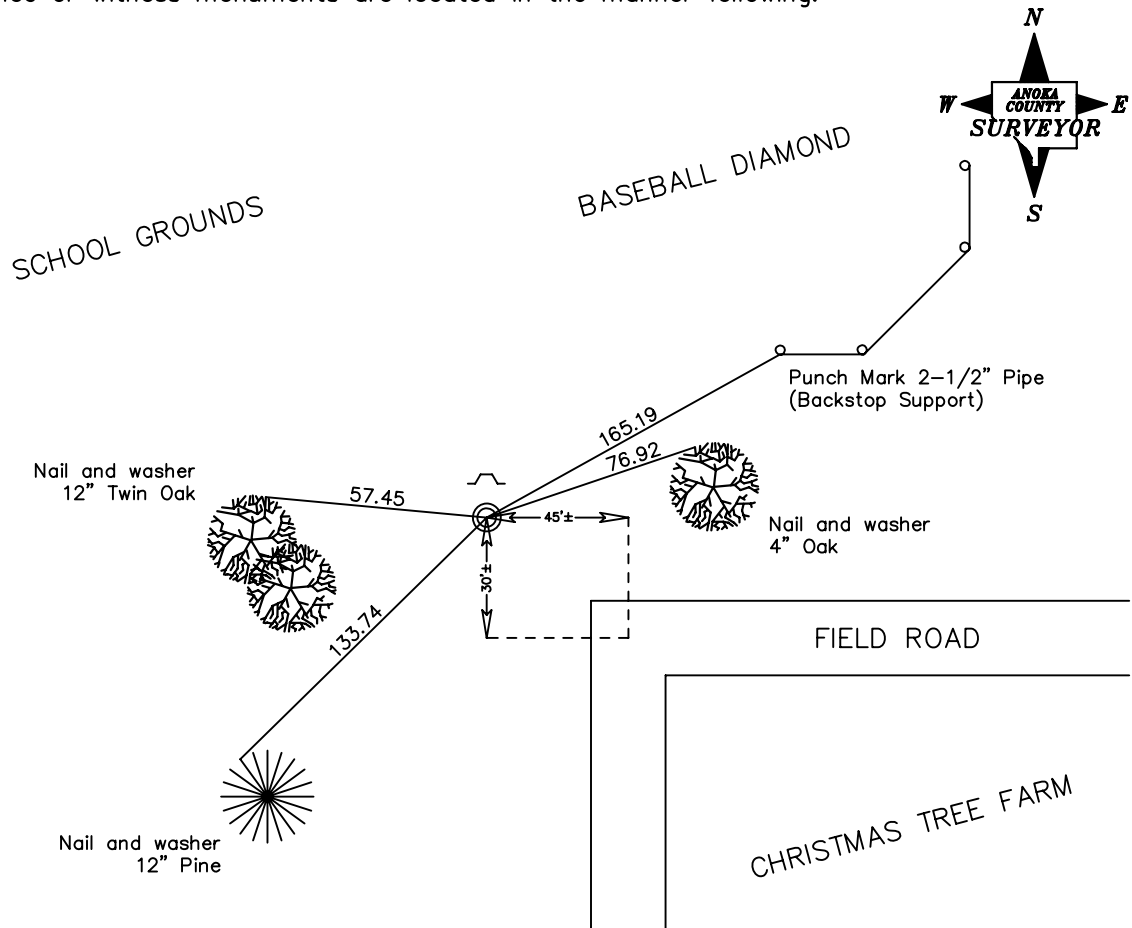

Revised date

6/22/82
6/6/85
8/1/88

N.A.D. 1983 Co-ordinates

County Project Co-ordinates	State Plane Co-ordinates
Northing _____	Y _____
Easting _____	X _____

Date(No GPS Info Taken)