## CERTIFICATE OF LOCATION OF GOVERNMENT CORNER

County of Anoka

State of Minnesota


Witness Corner of Sec. 29 Township 32 Range 24
(Witness corners to W 1/4 Sec. 29)

On the 22nd day of September, 1992, the described corner was evidenced by area resurvey

and to perpetuate the location of said corner, at the exact location thereof, a permanent marker was placed consisting of cast iron monuments at both witness corners

AND on the <u>14th</u> day of <u>January</u>, <u>2011</u>, said permanent marker was <u>found and the ties</u> were updated

Updated reference ties are as shown below.

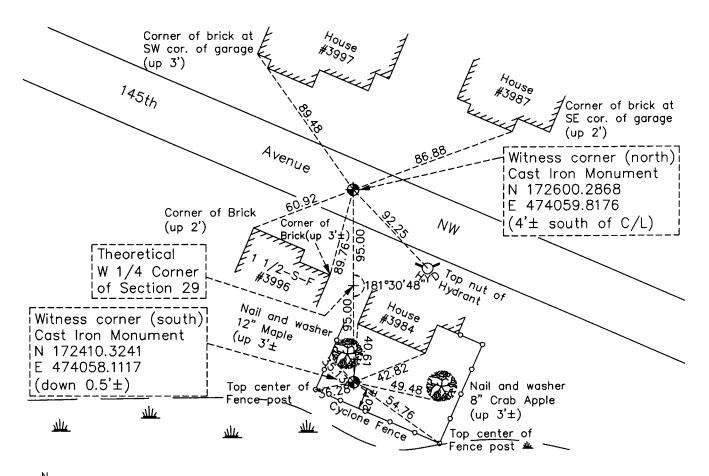



5/25/11

N.A.D. 1983 Coordinates (1996 Adjustment)

County F	Project Coordinates
Northing <u>See above</u>	
Easting	
Date	

I hereby certify that this United States public land survey monument record is correct and complete to the best of my knowledge and belief.

Larry D. Hoium , Anoka County Surveyor Minnesota License Number 18165

## HISTORY OF GOVERNMENT CORNER

County of Anoka

State of Minnesota

Witness Corner of Sec. 29 Township 32 Range 24 (Witness corners to W 1/4 Sec. 29)

## **CORNER HISTORY:**

November 15, 1962 - Found 1" iron pipe down 1' in south rut of east-west trail across field. Set 3/4" iron pipe above 1" iron pipe and flush with trail. Also set steel snow fence post 1'± south of iron pipe. Established ties to monument.

**November 12**, 1964 - Replaced 1" iron pipe with a cast iron monument set flush with the surface. No ties available in the area. Set steel fence posts 0.5' east and west of monument.

July 19, 1972 - Found cast iron monument down 0.2'± and updated ties. Set steel fence post 1.5' north of monument.

June 9, 1976 - Found cast iron monument and updated ties.

June 11, 1979 - Found cast iron monument and updated ties.

June 21, 1982 - Found cast iron monument and updated ties.

August 11, 1988 - Found cast iron monument and updated ties.

September 22, 1992 and November 30, 1992 - Set cast iron monuments as Witness corners to the West Quarter corner of Section 29 using area resurvey. Position of W1/4 corner falls in house. Witness corners are north and south of  $W_4^1$  corner. Set sign and post on south side of southerly monument and established ties to monuments.

July 30, 1993 - Found cast iron monument Witness corners and updated ties.

January 14, 2011 - Found cast iron monument Witness corners and updated ties. North Witness corner is 4'± south of centerline of 145th Avenue NW and south Witness corner is down 0.5'± and in backyard of House No. 3984.