

CERTIFICATE OF LOCATION OF GOVERNMENT CORNER

County of Anoka

State of Minnesota



Northeast Corner of Sec. 35 Township 32 Range 24

On the 10th day of May, 1960, the described corner was evidenced by a granite monument

and to perpetuate the location of said corner, at the exact location thereof, a permanent marker was placed consisting of the same granite monument with a sign and post on the north side

AND on the 31st day of January, 2011, said permanent marker was found and the ties were updated

Updated reference ties are as shown below.

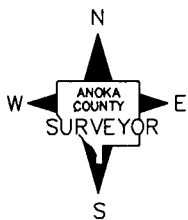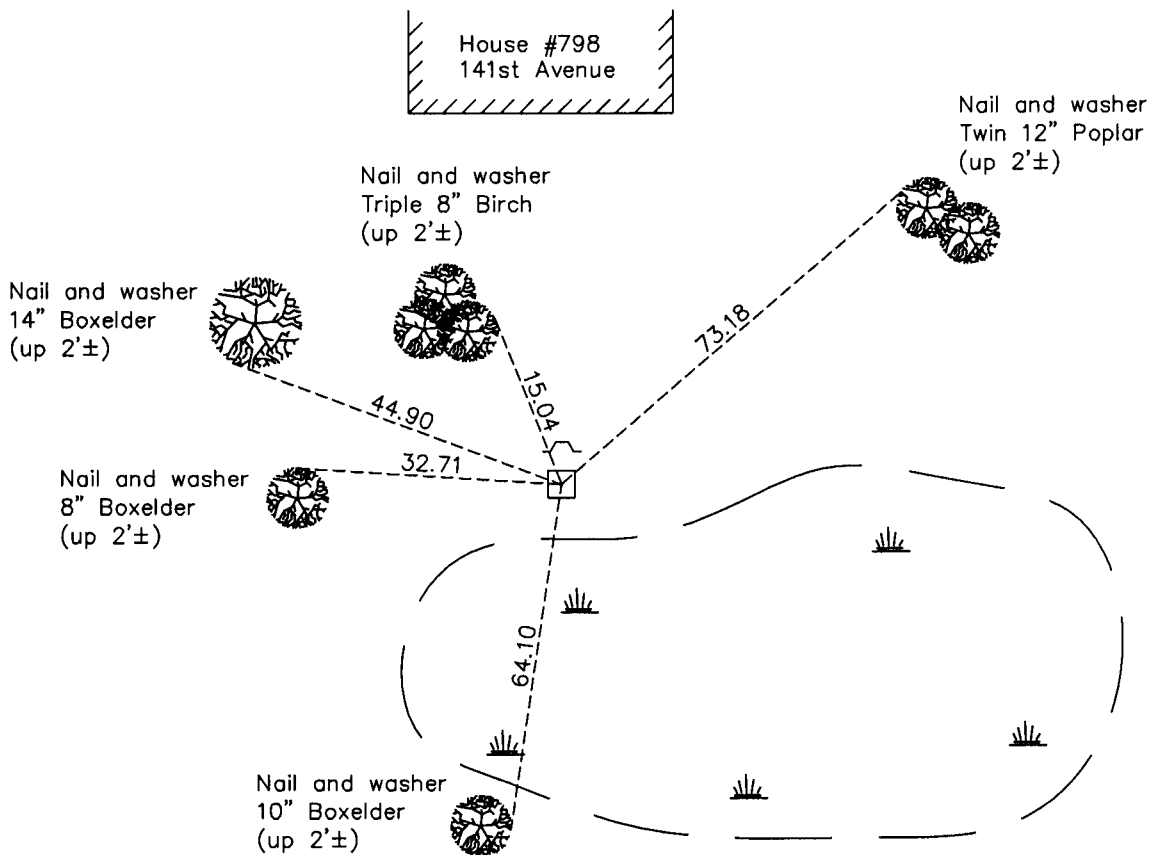

Revision Date
6/13/11

N.A.D. 1983 Coordinates
(1996 Adjustment)

County Project Coordinates	
Northing	<u>169608.4863</u>
Easting	<u>495080.4105</u>
Date	<u>11/27/00</u>

I hereby certify that this United States public land survey monument record is correct and complete to the best of my knowledge and belief.

Larry D. Hoium Date 6/13/11

Larry D. Hoium, Anoka County Surveyor

Minnesota License Number 18165

HISTORY OF GOVERNMENT CORNER

Page No. 100

County of Anoka

State of Minnesota

Northeast Corner of Sec. 35 Township 32 Range 24

CORNER HISTORY:

May 10, 1960 - Found granite monument leaning $1' \pm$ east. Straightened granite monument and lowered it enough to set a cast iron monument on top of it. Cast iron monument was set up $0.3' \pm$ above the surface. Established ties to monument.

August 26, 1964 - Found cast iron monument and updated ties.

July 23, 1968 - Found cast iron monument and updated ties.

July 10, 1972 - Found cast iron monument and updated ties.

June 9, 1976 - Found cast iron monument and updated ties.

June 13, 1979 - Found cast iron monument and updated ties.

July 7, 1982 - Found cast iron monument and updated ties.

August 5, 1988 - Found cast iron monument and updated ties.

April 30, 1993 - Removed cast iron monument and updated ties to granite monument. Set sign and post on north side of monument.

November 27, 2000 - Found granite monument and established NAD 1983 (1996 Adjustment) Anoka County Project Coordinates by Static GPS methods. Updated ties.

January 31, 2011 - Found granite monument with sign and post on north side and updated ties.