

# CERTIFICATE OF LOCATION OF GOVERNMENT CORNER

County of Anoka

State of Minnesota



## East 1/4 Corner of Sec. 36 Township 32 Range 24

On the 14th day of September, 1960, the described corner was evidenced by a Tee iron

and to perpetuate the location of said corner, at the exact location thereof, a permanent marker was placed consisting of a cast iron monument with a sign and post on the southwest side

AND on the 7th day of October, 2010, said permanent marker was found flush with the surface and the ties were updated

Updated reference ties are as shown below.

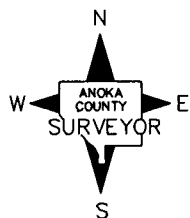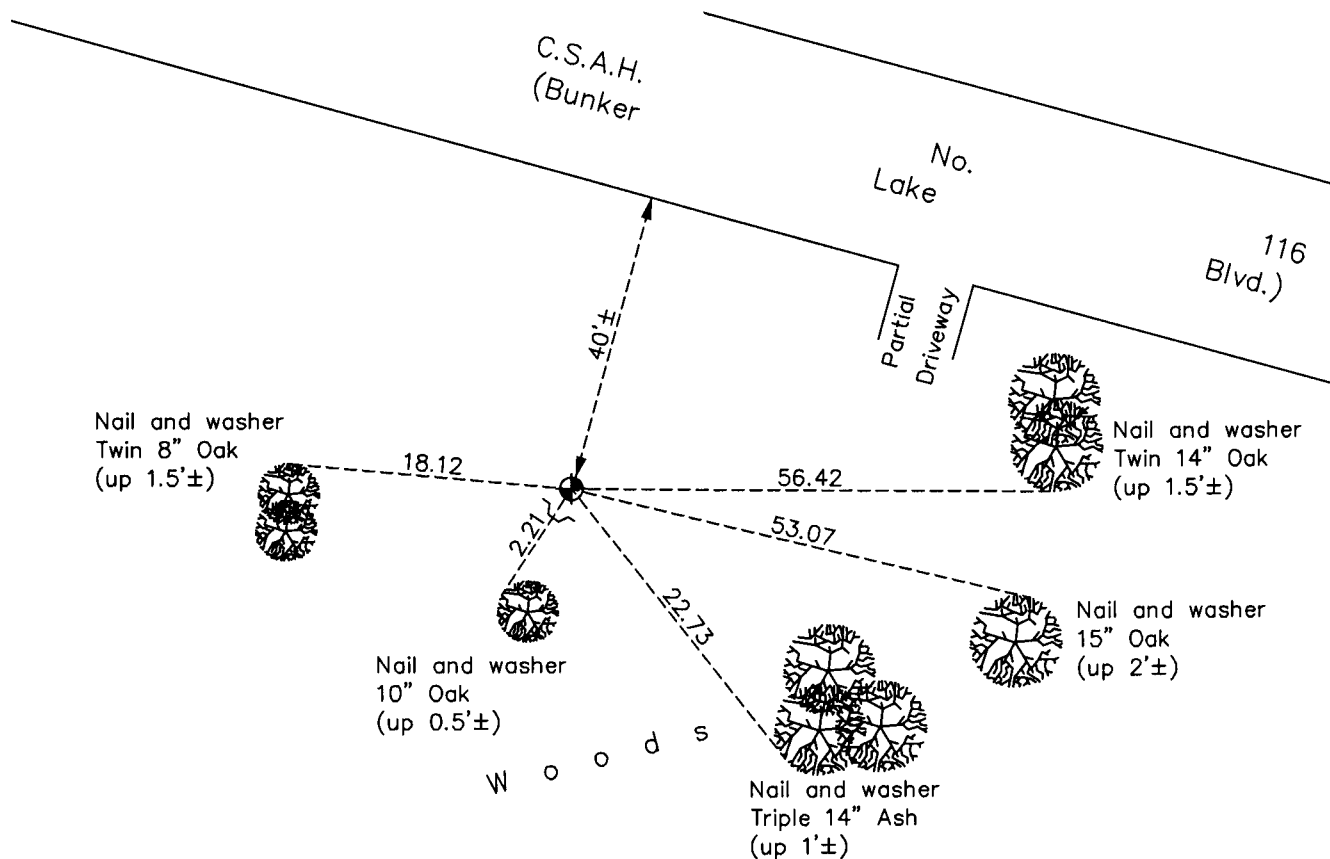

Revision Date

7/14/11

N.A.D. 1983 Coordinates  
(1996 Adjustment)

County Project Coordinates	
Northing	166943.3017
Easting	500245.8501
Date	11/29/00

I hereby certify that this United States public land survey monument record is correct and complete to the best of my knowledge and belief.

*Larry D. Hoium* Date 7/14/11

Larry D. Hoium, Anoka County Surveyor  
Minnesota License Number 18165

# HISTORY OF GOVERNMENT CORNER

Page No. 126

County of Anoka

State of Minnesota

## East 1/4 Corner of Sec. 36 Township 32 Range 24

### **CORNER HISTORY:**

September 14, 1960 - Found T iron down 0.1' with field stones placed around it. Established ties to monument.

June 9, 1964 - Found iron and rocks undisturbed.

July 22, 1964 - Found T iron and updated ties.

August 5, 1966 - Found T iron and updated ties.

October 7, 1966 - Replaced T iron with a cast iron monument. Updated ties.

May 20, 1971 - Found cast iron monument and updated ties.

June 13, 1975 - Found cast iron monument and updated ties.

June 20, 1978 - Found cast iron monument and updated ties.

July 6, 1981 - Found cast iron monument and updated ties.

June 27, 1984 - Found cast iron monument and updated ties.

June 30, 1987 - Found cast iron monument and updated ties.

November 20, 1991 - Found cast iron monument and updated ties.

November 29, 2000 - Found cast iron monument and established NAD 1983 (1996 Adjustment) Anoka County Project Coordinates by Static GPS methods. Set sign and post on the southwest side of monument and updated ties.

October 7, 2010 - Found cast iron monument flush with the surface and with sign and post on the southwest side of monument. Updated ties.