

# CERTIFICATE OF LOCATION OF GOVERNMENT CORNER

County of Anoka

State of Minnesota


## South 1/4 Corner of Sec. 34 Township 31 Range 23

On the 28th day of October, 1964, the described corner was evidenced by a cast iron monument

and to perpetuate the location of said corner, at the exact location thereof, a permanent marker was placed consisting of a cast iron monument

AND on the 31st day of July, 2014, said permanent marker was found missing. Set new cast iron monument and updated ties.

Updated reference ties are as shown below.

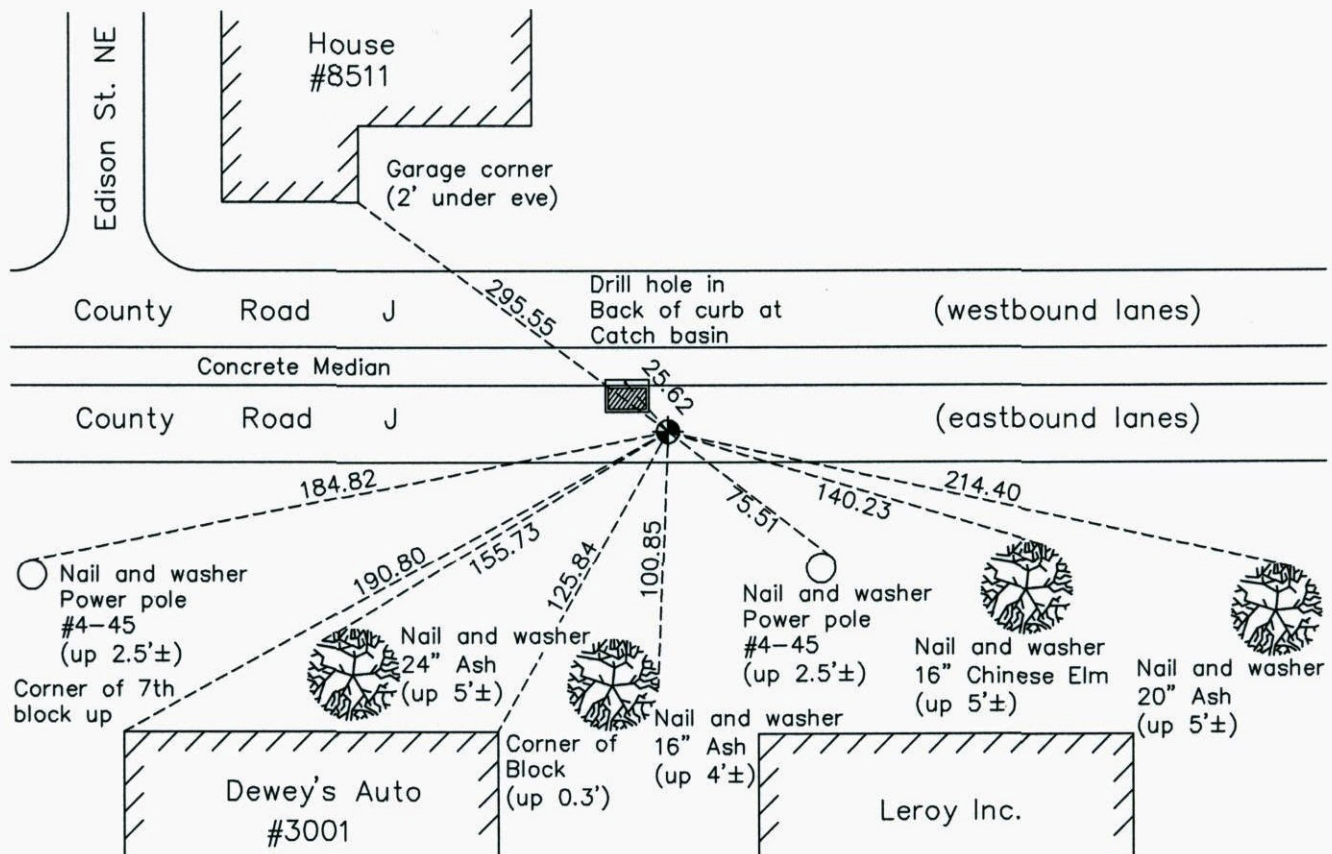

Revision Date  
8/12/14

N.A.D. 1983 Coordinates  
(1996 Adjustment)

County Project Coordinates	
Northing	132493.3342
Easting	518642.7356
Date	7/27/99

I hereby certify that this United States public land survey monument record is correct and complete to the best of my knowledge and belief.

*Larry D. Hoium* Date 8/12/14

Larry D. Hoium, Anoka County Surveyor  
Minnesota License Number 18165