CERTIFICATE OF LOCATION OF GOVERNMENT CORNER

County of Anoka State of Minnesota

West 1/4 Corner of Sec. 8 Township 33 Range 23

On the 5th day of February, 1963, the described corner was evidenced by a cast iron monument

and to perpetuate the location of said corner, at the exact location thereof, a permanent marker was placed consisting of a cast iron monument with a sign and post on the west side

AND on the 23rd day of January, 2013, said permanent marker was found missing. Set new cast iron monument flush with the surface on May 30, 2013 and updated ties on June 3, 2013.

Updated reference ties are as shown below.

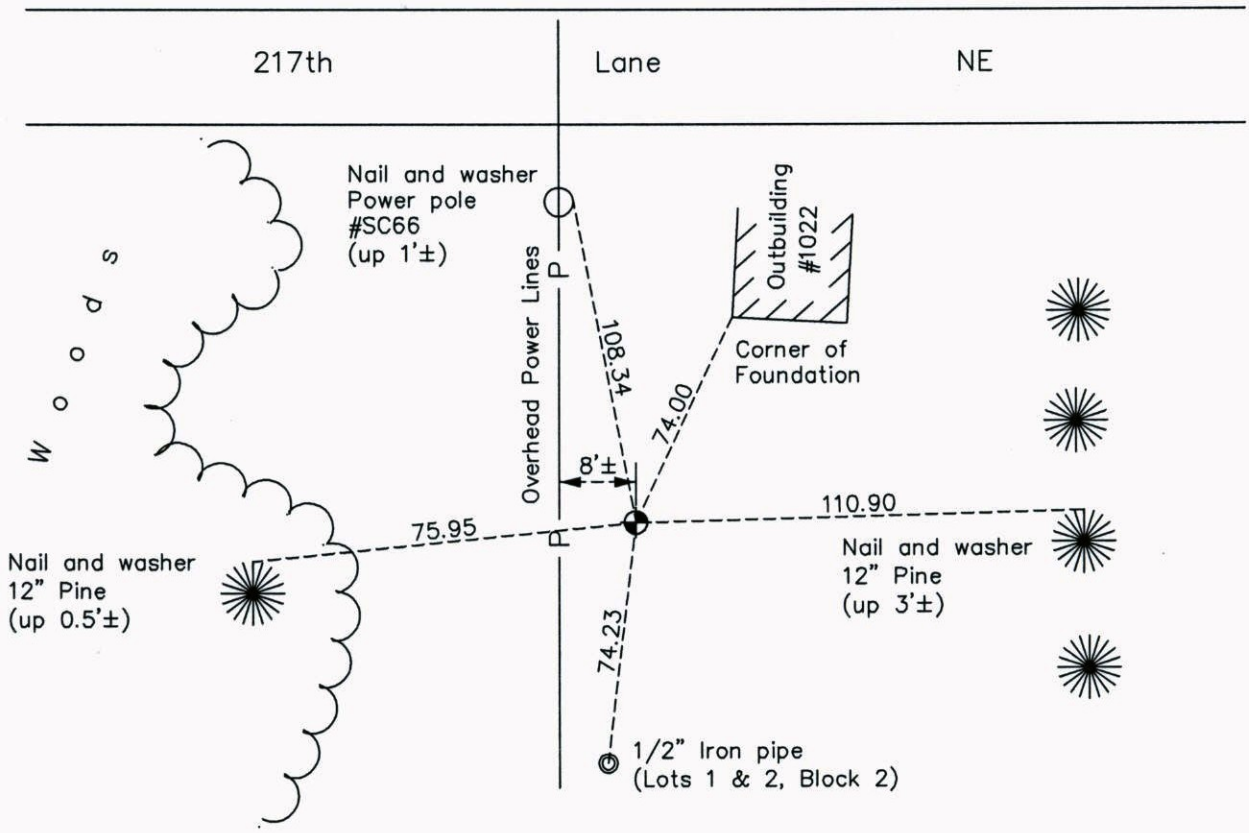

N
W ANOKA COUNTY SURVEYOR E
S

Revision Date
8/22/14

N.A.D. 1983 Coordinates
(1996 Adjustment)

County Project Coordinates	
Northing	219647.2576
Easting	505023.7635
Date	3/17/03

I hereby certify that this United States public land survey monument record is correct and complete to the best of my knowledge and belief.

Larry D. Hoium Date 8/22/14

Larry D. Hoium, Anoka County Surveyor

Minnesota License Number 18165