

# CERTIFICATE OF LOCATION OF GOVERNMENT CORNER

County of Anoka

State of Minnesota


## Southeast Corner of Sec. 23 Township 33 Range 25

On the 2nd day of October, 1963, the described corner was evidenced by a 6"X6" granite monument

and to perpetuate the location of said corner, at the exact location thereof, a permanent marker was placed consisting of a cast iron monument with a sign and post on the south side

AND on the 28th day of March, 2013, said permanent marker was found down 0.9'± and the ties were updated.

Updated reference ties are as shown below.

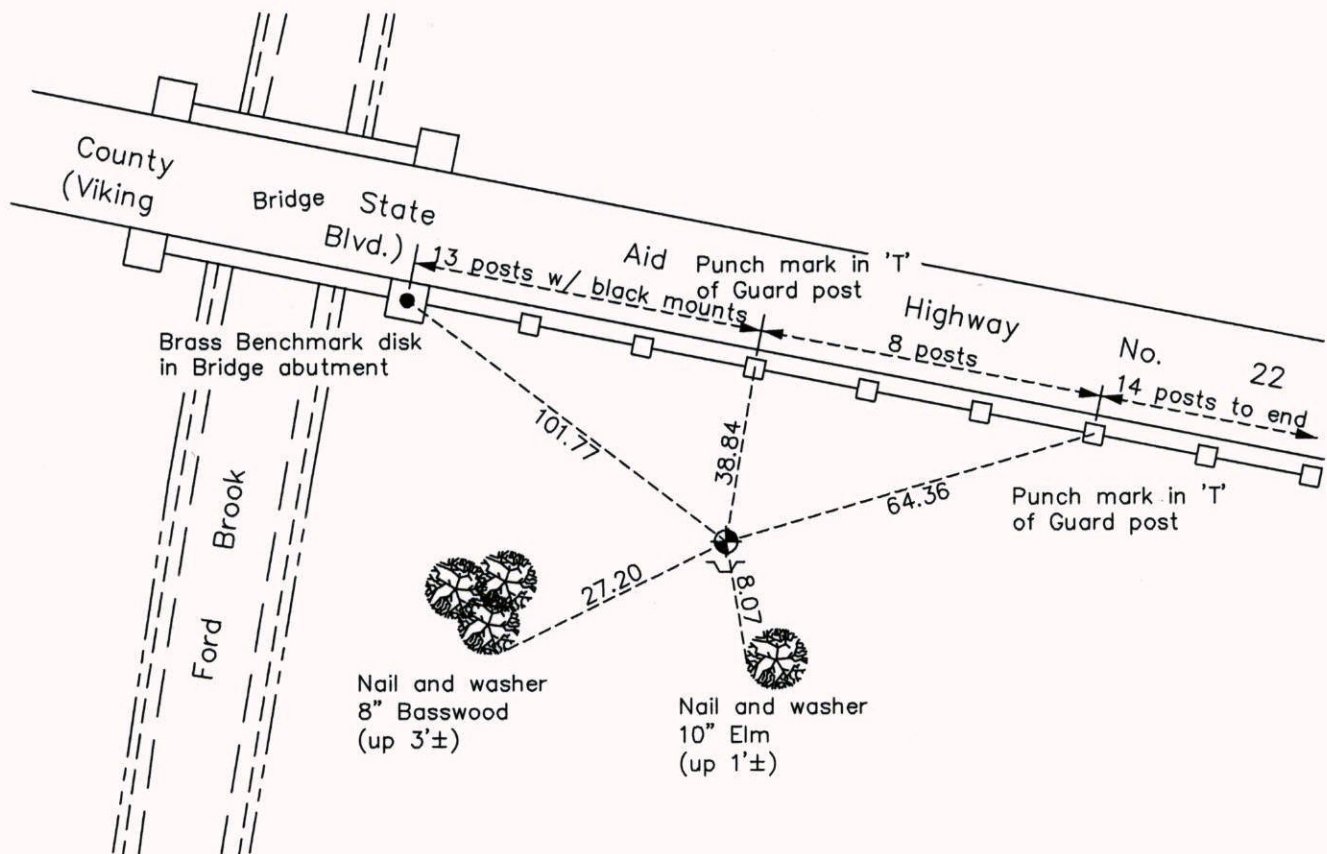

Revision Date  
8/16/11

N.A.D. 1983 Coordinates  
(1996 Adjustment)

County Project Coordinates	
Northing	<u>206700.3146</u>
Easting	<u>463390.6178</u>
Date	<u>9/26/02</u>

I hereby certify that this United States public land survey monument record is correct and complete to the best of my knowledge and belief.

*Larry D. Hoium* Date 8/25/14

Larry D. Hoium, Anoka County Surveyor

Minnesota License Number 18165