

CERTIFICATE OF LOCATION OF GOVERNMENT CORNER

County of Anoka

State of Minnesota


Northeast Corner of Sec. 22 Township 33 Range 24

On the 29th day of June, 1960, the described corner was evidenced by a granite monument

and to perpetuate the location of said corner, at the exact location thereof, a permanent marker was placed consisting of a cast iron monument

AND on the 5th day of November, 2011, said permanent marker was found missing. Replaced with new cast iron monument and ties were updated on June 24, 2013.

Updated reference ties are as shown below.

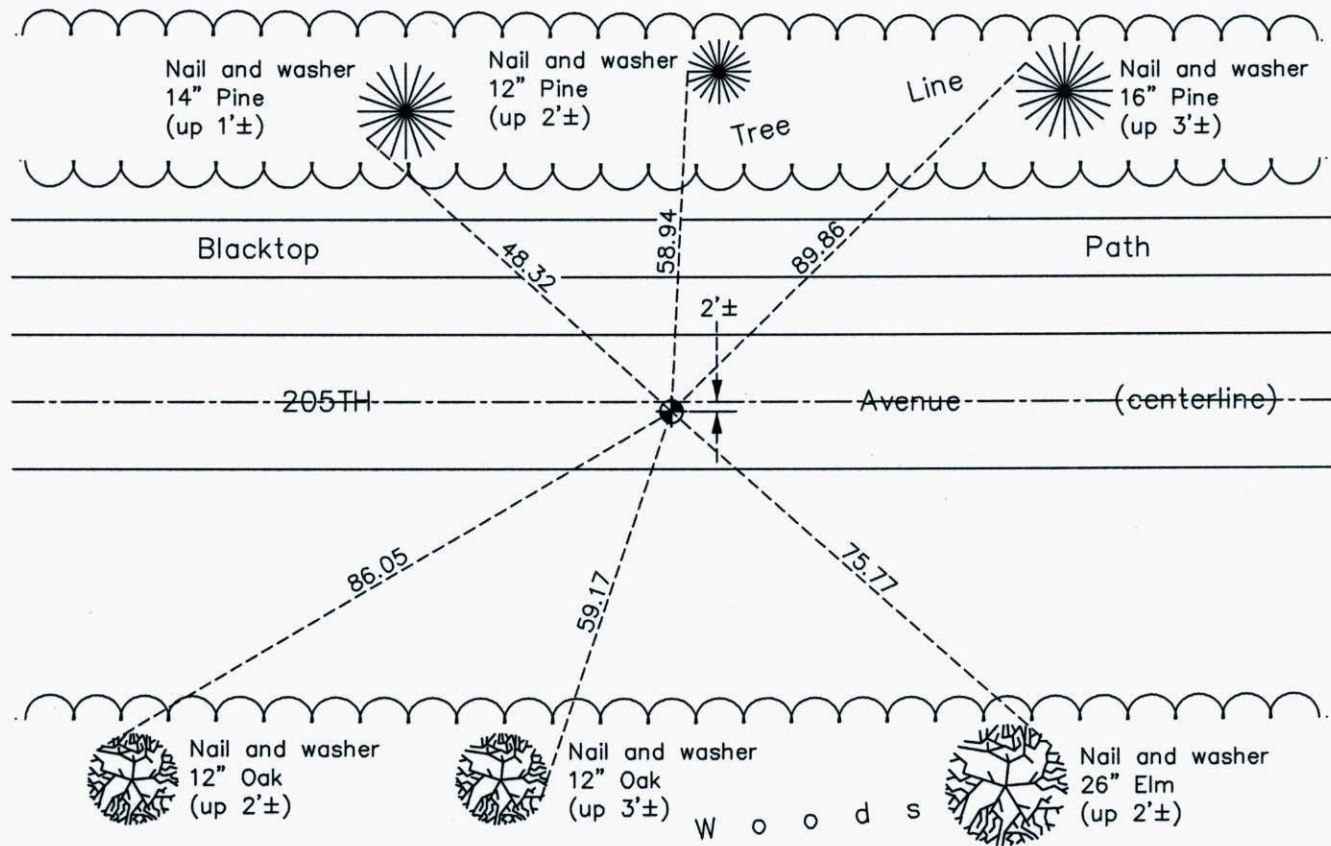

N

S

Revision Date

9/29/14

N.A.D. 1983 Coordinates
(1996 Adjustment)

County Project Coordinates	
Northing	<u>211605.9470</u>
Easting	<u>489675.8152</u>
Date	<u>3/26/01</u>

I hereby certify that this United States public land survey monument record is correct and complete to the best of my knowledge and belief.

Date 9/29/14

Larry D. Hoium, Anoka County Surveyor
 Minnesota License Number 18165