

CERTIFICATE OF LOCATION OF GOVERNMENT CORNER

County of Anoka

State of Minnesota


South 1/4 Corner of Sec. 1 Township 31 Range 25

On the 22nd day of January, 1988, the described corner was evidenced by area resurvey

and to perpetuate the location of said corner, at the exact location thereof, a permanent marker was placed consisting of a cast iron monument

AND on the 16th day of March, 2015, said permanent marker was found and the ties
were updated

Updated reference ties are as shown below.

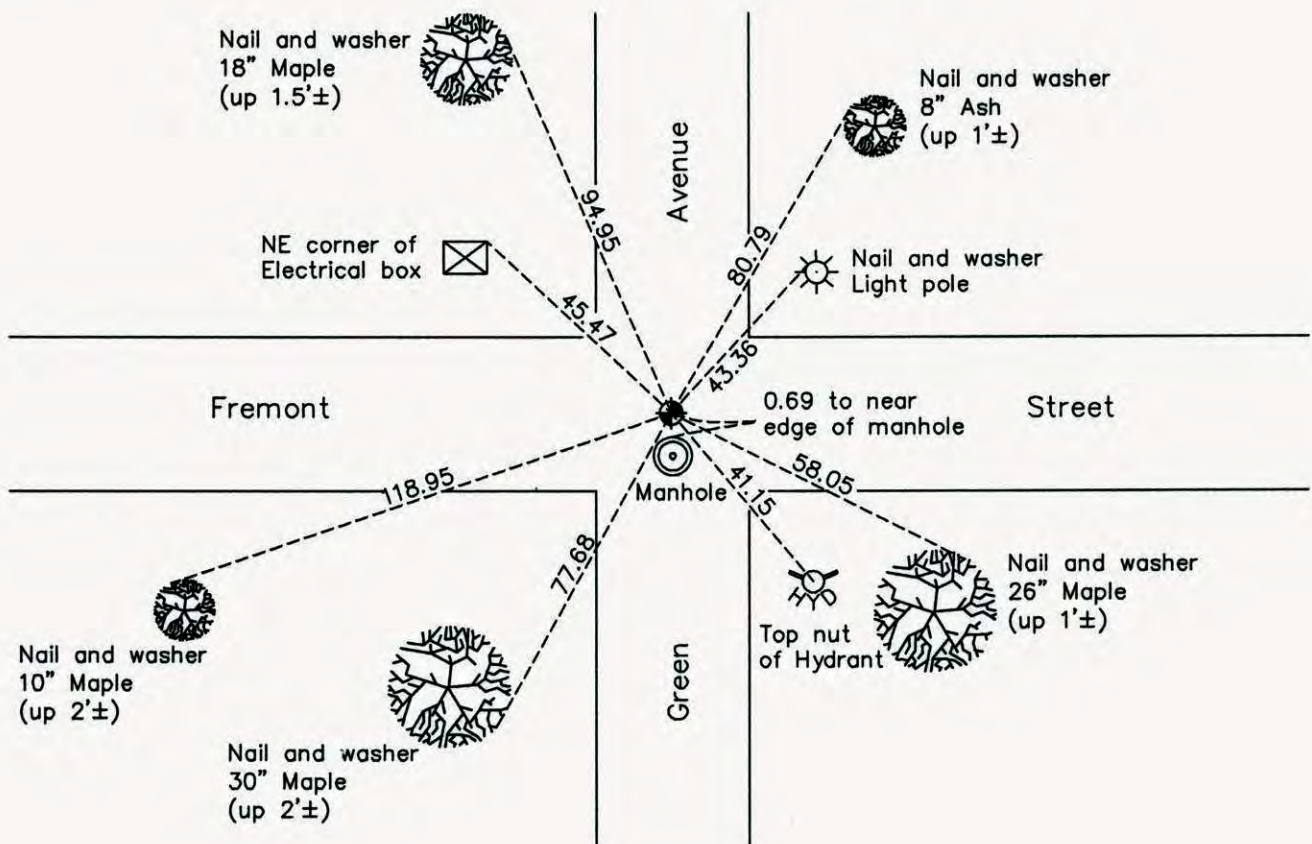

N
W ANOKA COUNTY SURVEYOR E
S

Revision Date
4/15/15

N.A.D. 1983 Coordinates
(1996 Adjustment)

County Project Coordinates	
Northing	159315.2652
Easting	465855.8207
Date	6/19/01

I hereby certify that this United States public land survey monument record is correct and complete to the best of my knowledge and belief.

Larry D. Hoium Date 4/15/15

Larry D. Hoium, Anoka County Surveyor
Minnesota License Number 18165

HISTORY OF GOVERNMENT CORNER

County of Anoka

State of Minnesota

South 1/4 Corner of Sec. 1 Township 31 Range 25

CORNER HISTORY:

January 22, 1988 - Set P.K. nail using area resurvey and platting and established ties to monument.

January 27, 1988 - Replaced P.K. nail with a 1/2" iron pipe set on a straight line extended southerly from the North 1/4 corner through a found 3/4" iron pipe at the Center of Section and intersecting an east-west line using area platting. The position of the 1/2" iron pipe is 0.19' west of the P.K. nail. Updated ties.

June 9, 1988 - Replaced 1/2" iron pipe with a cast iron monument. Updated ties.

August 9, 1990 - Found cast iron monument and updated ties.

August 19, 1994 - Found cast iron monument and updated ties.

June 19, 2001 - Found cast iron monument and established NAD 1983 (1996 Adjustment) Anoka County Project Coordinates by Static GPS methods. Updated ties.

October 1, 2010 - Found cast iron monument and updated ties.

March 16, 2015 - Found cast iron monument and updated ties.