

CERTIFICATE OF LOCATION OF GOVERNMENT CORNER

County of Anoka

State of Minnesota


Northeast Corner of Sec. 1 Township 31 Range 23

On the 3rd day of October, 1961, the described corner was evidenced by a granite monument

and to perpetuate the location of said corner, at the exact location thereof, a permanent marker was placed consisting of the same granite monument with a sign and post on the north side

AND on the 22nd day of April, 2014, said permanent marker was found and the ties were updated

Updated reference ties are as shown below.

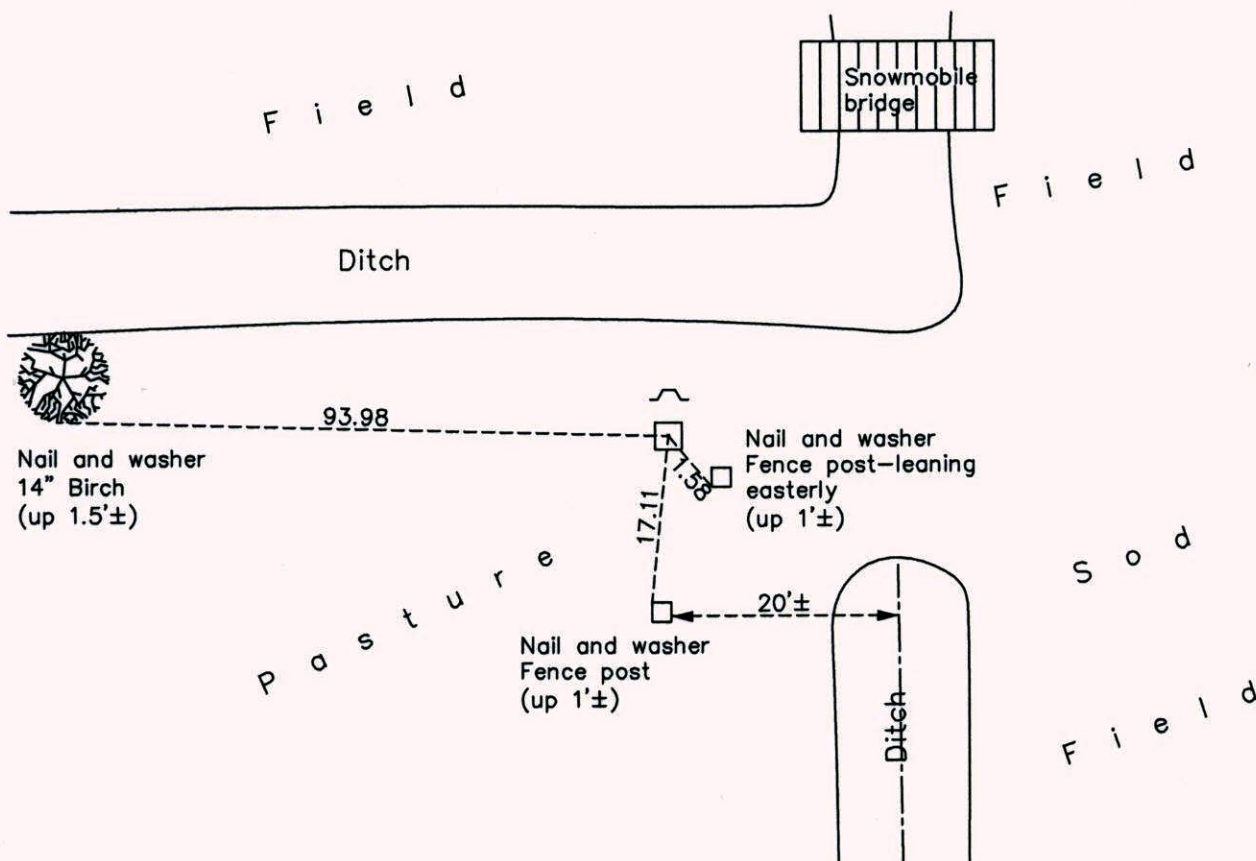

Revision Date
12/11/14

N.A.D. 1983 Coordinates
(1996 Adjustment)

County Project Coordinates	
Northing	164113.1719
Easting	531998.2177
Date	10/09/98

I hereby certify that this United States public land survey monument record is correct and complete to the best of my knowledge and belief.

Larry D. Hoium Date 12/11/14

Larry D. Hoium, Anoka County Surveyor
Minnesota License Number 18165