

# CERTIFICATE OF LOCATION OF GOVERNMENT CORNER

County of Anoka

State of Minnesota


## North 1/4 Corner of Sec. 1 Township 31 Range 23

On the 15th day of May, 1974, the described corner was evidenced by a cast iron monument from area resurvey

and to perpetuate the location of said corner, at the exact location thereof, a permanent marker was placed consisting of a cast iron monument with a sign and post on the south side

AND on the 22nd day of April, 2014, said permanent marker was found and the ties were updated

Updated reference ties are as shown below.

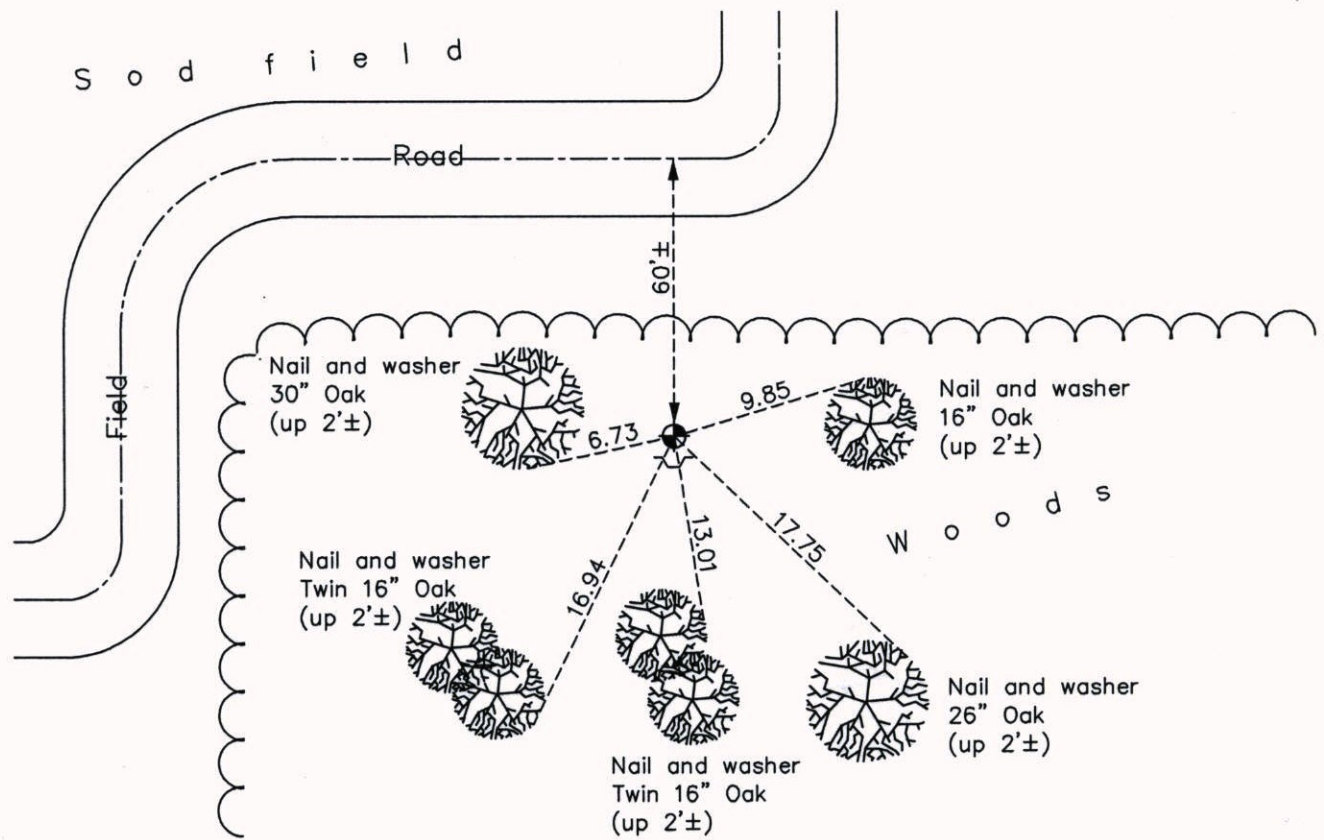

N

S

Revision Date

12/11/14

N.A.D. 1983 Coordinates  
(1996 Adjustment)

County Project Coordinates	
Northing	164143.2354
Easting	529365.8843
Date	11/05/99

I hereby certify that this United States public land survey monument record is correct and complete to the best of my knowledge and belief.

*Larry D. Hoium* Date 12/11/14

Larry D. Hoium, Anoka County Surveyor

Minnesota License Number 18165