## CERTIFICATE OF LOCATION OF GOVERNMENT CORNER

County of Anoka


State of Minnesota

## East 1/4 Corner of Sec. 5 Township 31 Range 23

On the \_\_7th\_\_ day of \_\_\_\_ April\_\_\_, \_\_1986, the described corner was evidenced by <u>area resurvey</u> and to perpetuate the location of said corner, at the exact location thereof, a permanent marker was placed consisting of <u>a cast iron monument with a sign and post on the east side</u>

AND on the \_\_14th\_\_ day of \_\_\_\_ May \_\_\_, \_\_2014, said permanent marker was <u>found down 1'± and</u> the ties were updated

Updated reference ties are as shown below.

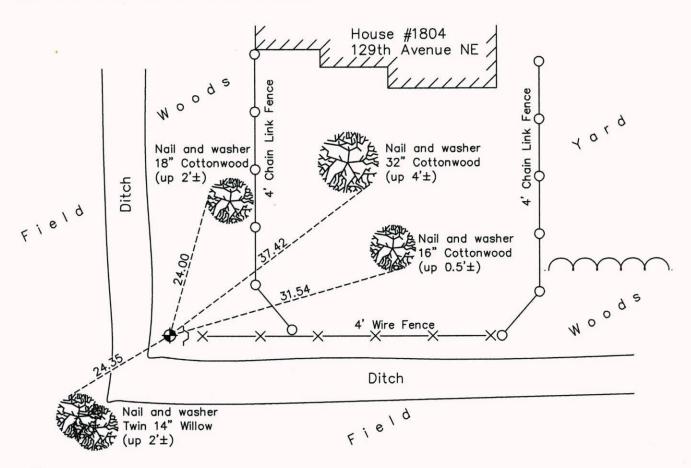



12/22/14

N.A.D. 1983 Coordinates (1996 Adjustment)

County Project Coordinates	
Northing	161665.5396
Easting	510888.0280
Date	11/09/98

I hereby certify that this United States public land survey monument record is correct and complete to the best of my knowledge and belief.

Date 12/22/14

Larry D. Hoium, Anoka County Surveyor

Minnesota License Number \_\_\_\_\_18165