

CERTIFICATE OF LOCATION OF GOVERNMENT CORNER

County of Anoka

State of Minnesota


North 1/4 Corner of Sec. 12 Township 31 Range 23

On the 20th day of November, 1964, the described corner was evidenced by area resurvey

and to perpetuate the location of said corner, at the exact location thereof, a permanent marker was placed consisting of a cast iron monument

AND on the 2nd day of June, 2014, said permanent marker was found on centerline-centerline and the ties were updated

Updated reference ties are as shown below.

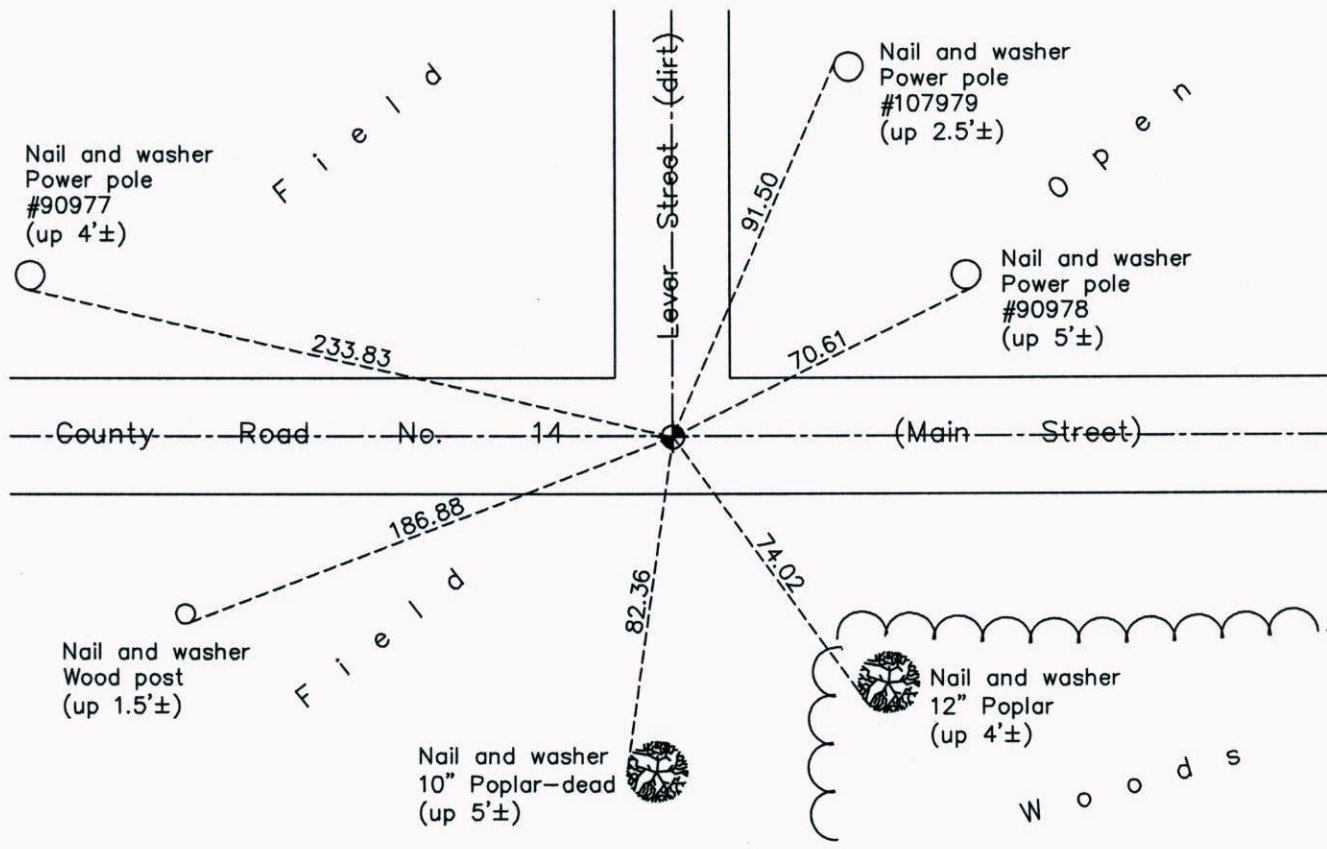

Revision Date

12/23/14

N.A.D. 1983 Coordinates
(1996 Adjustment)

County Project Coordinates	
Northing	158802.3656
Easting	529393.6785
Date	9/02/98

I hereby certify that this United States public land survey monument record is correct and complete to the best of my knowledge and belief.

Larry D. Hoium Date 12/23/14

Larry D. Hoium, Anoka County Surveyor
Minnesota License Number 18165