CERTIFICATE OF LOCATION OF GOVERNMENT CORNER


County of Anoka

State of Minnesota

North 1/4 Corner of Sec. 9 Township 31 Range 23

On the 9th day of November, 1973, the described corner was evidenced by area resurvey and to perpetuate the location of said corner, at the exact location thereof, a permanent marker was placed consisting of a cast iron monument AND on the 30th day of ______, 2014, said permanent marker was found on centerline and the ties were updated

Updated reference ties are as shown below.

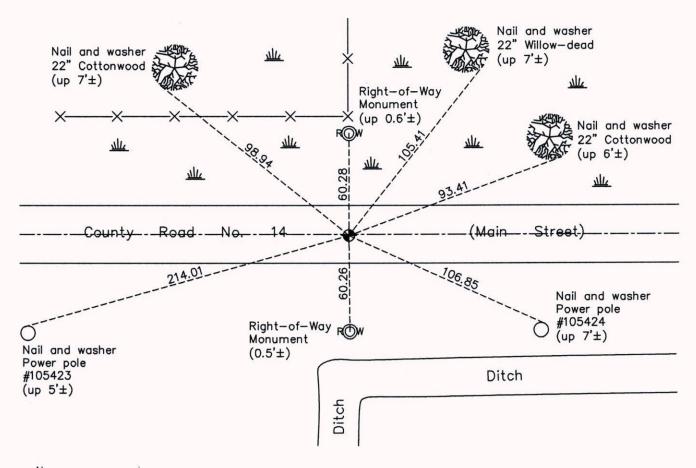



Revision Date

12/24/14

N.A.D. 1983 Coordinates (1996 Adjustment)

County Project Coordinates Northing 159038.6176 Easting <u>513535.2675</u> 9/03/98 Date

I hereby certify that this United States public land survey monument record is correct and complete to the best of my knowledge and belief. Date 12

Larry D. Hoium , Anoka County Surveyor Minnesota License Number _