

CERTIFICATE OF LOCATION OF GOVERNMENT CORNER

County of Anoka

State of Minnesota


Northwest Corner of Sec. 9 Township 31 Range 23

On the 3rd day of May, 1963, the described corner was evidenced by an iron pipe

and to perpetuate the location of said corner, at the exact location thereof, a permanent marker was placed consisting of a cast iron monument

AND on the 5th day of June, 2014, said permanent marker was found and the ties
were updated

Updated reference ties are as shown below.

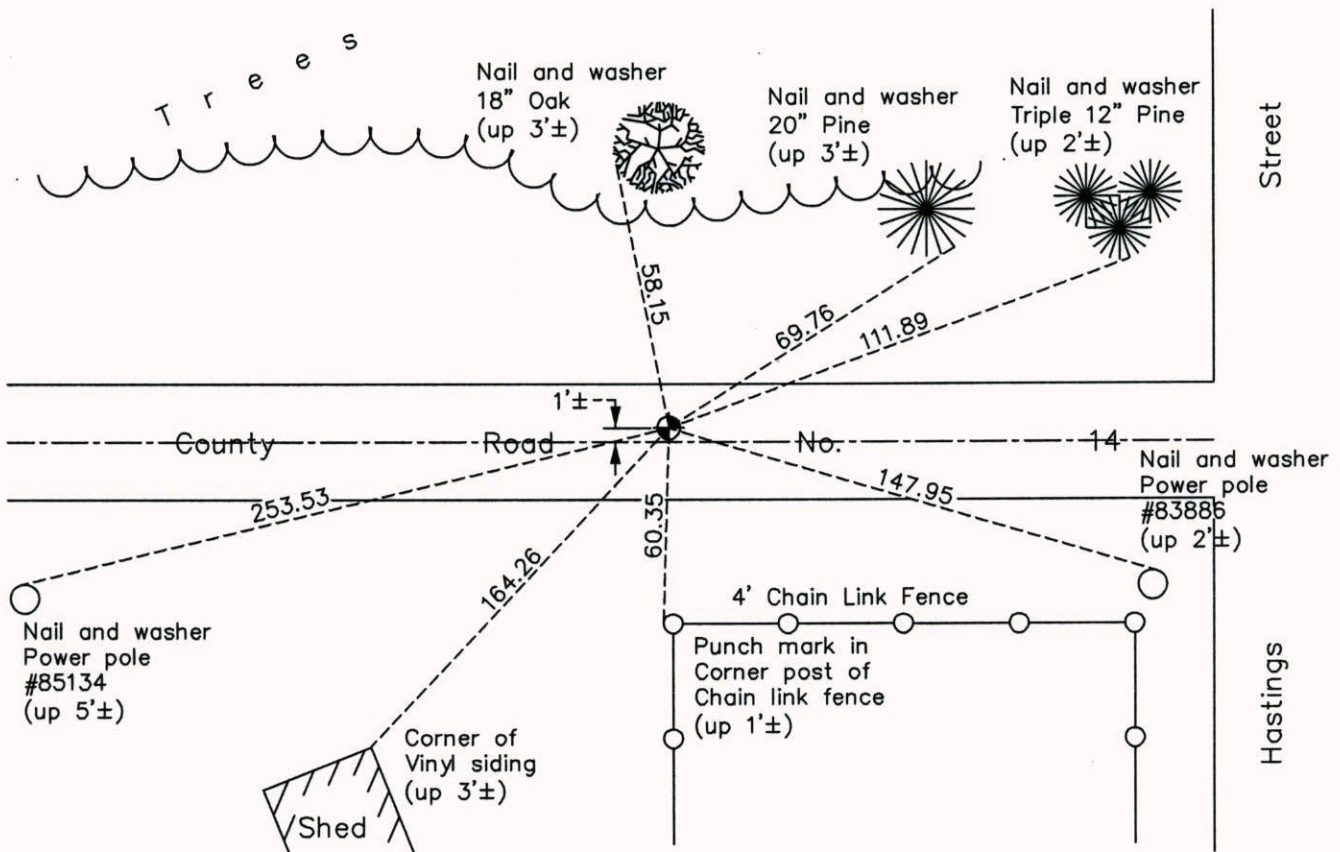

N

W ANOKA COUNTY SURVEYOR E

S

Revision Date

12/24/14

N.A.D. 1983 Coordinates
(1996 Adjustment)

County Project Coordinates	
Northing	159054.2234
Easting	510865.1972
Date	9/03/98

I hereby certify that this United States public land survey monument record is correct and complete to the best of my knowledge and belief.

Larry D. Hoium Date 12/24/14

Larry D. Hoium, Anoka County Surveyor

Minnesota License Number 18165