## CERTIFICATE OF LOCATION OF GOVERNMENT CORNER

County of Anoka


State of Minnesota

## South 1/4 Corner of Sec. 6 Township 31 Range 23

On the 30th day of August , 1960, the described corner was evidenced by an iron pipe and to perpetuate the location of said corner, at the exact location thereof, a permanent marker was placed consisting of a cast iron monument

AND on the 5th day of June , 2014, said permanent marker was found and the ties were updated

Updated reference ties are as shown below.

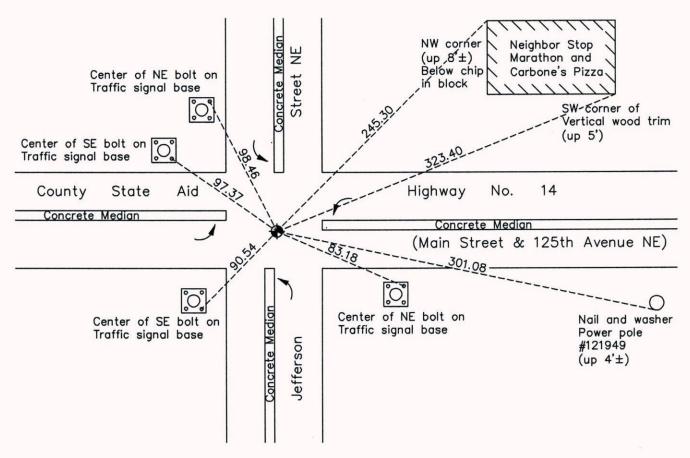



12/24/14

N.A.D. 1983 Coordinates (1996 Adjustment)

 County Project Coordinates

 Northing 158997.9871

 Easting 502882.4024

 Date 9/03/98