

CERTIFICATE OF LOCATION OF GOVERNMENT CORNER

County of Anoka

State of Minnesota


West 1/4 Corner of Sec. 24 Township 31 Range 23

On the 21st day of October, 1968, the described corner was evidenced by area resurvey

and to perpetuate the location of said corner, at the exact location thereof, a permanent marker was placed consisting of a cast iron monument

AND on the 21st day of May, 2014, said permanent marker was found and the ties
were updated

Updated reference ties are as shown below.

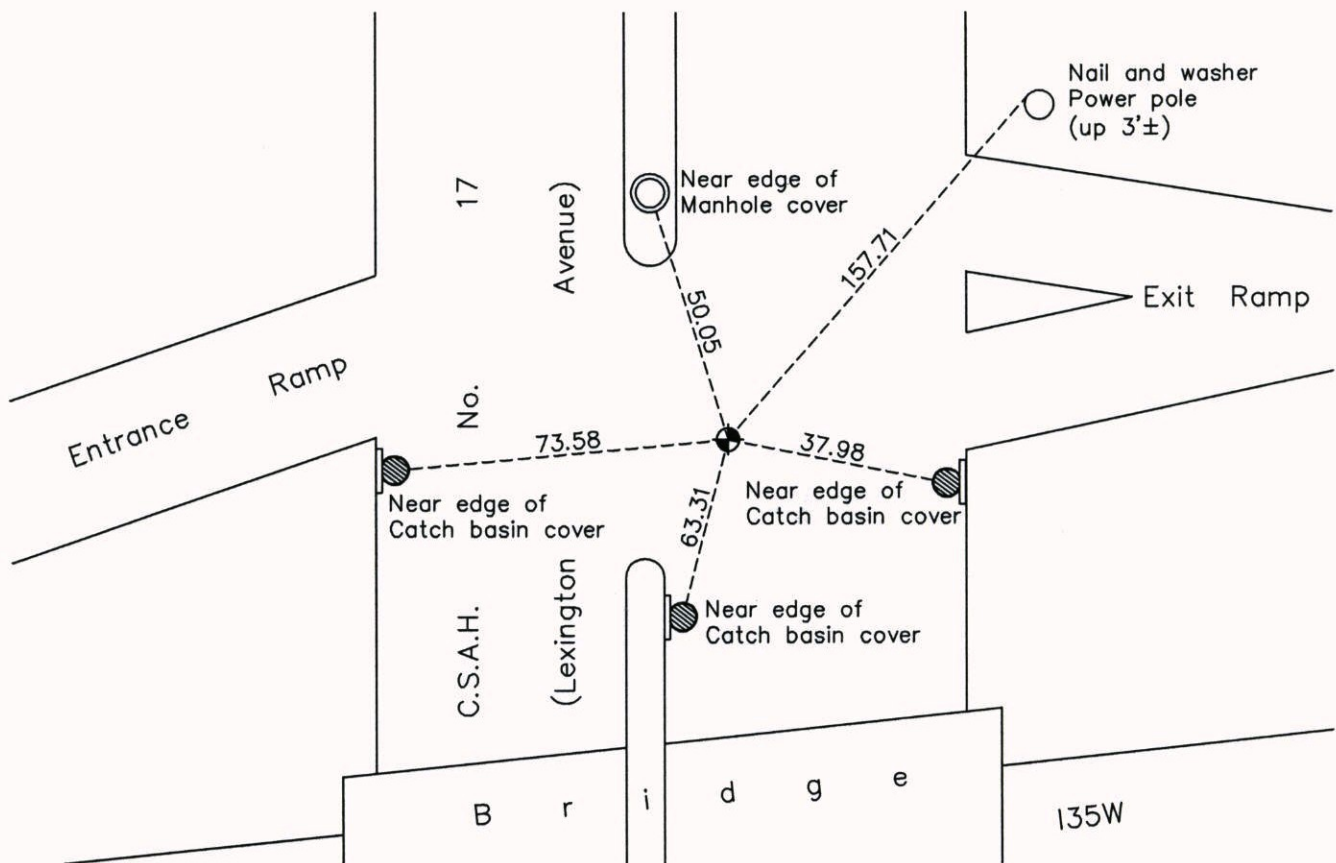

Revision Date
2/19/15

N.A.D. 1983 Coordinates
(1996 Adjustment)

County Project Coordinates	
Northing	145615.3480
Easting	526677.7228
Date	10/15/98

I hereby certify that this United States public land survey monument record is correct and complete to the best of my knowledge and belief.

Larry D. Hoium Date 2/19/15

Larry D. Hoium, Anoka County Surveyor
Minnesota License Number 18165