

# CERTIFICATE OF LOCATION OF GOVERNMENT CORNER


County of Anoka                      State of Minnesota

CENTER Corner of Sec. 30 Township 31 Range 23

I hereby certify that on the 8 day of NOV., 1961, I found the described corner which was evidenced by 3/4" PINCHED IRON PIPE

and I further certify that to perpetuate the location of said corner, I did, at the exact location thereof, place a permanent marker consisting of CAST IRON MON.

which reference or witness monuments are located in the manner following:

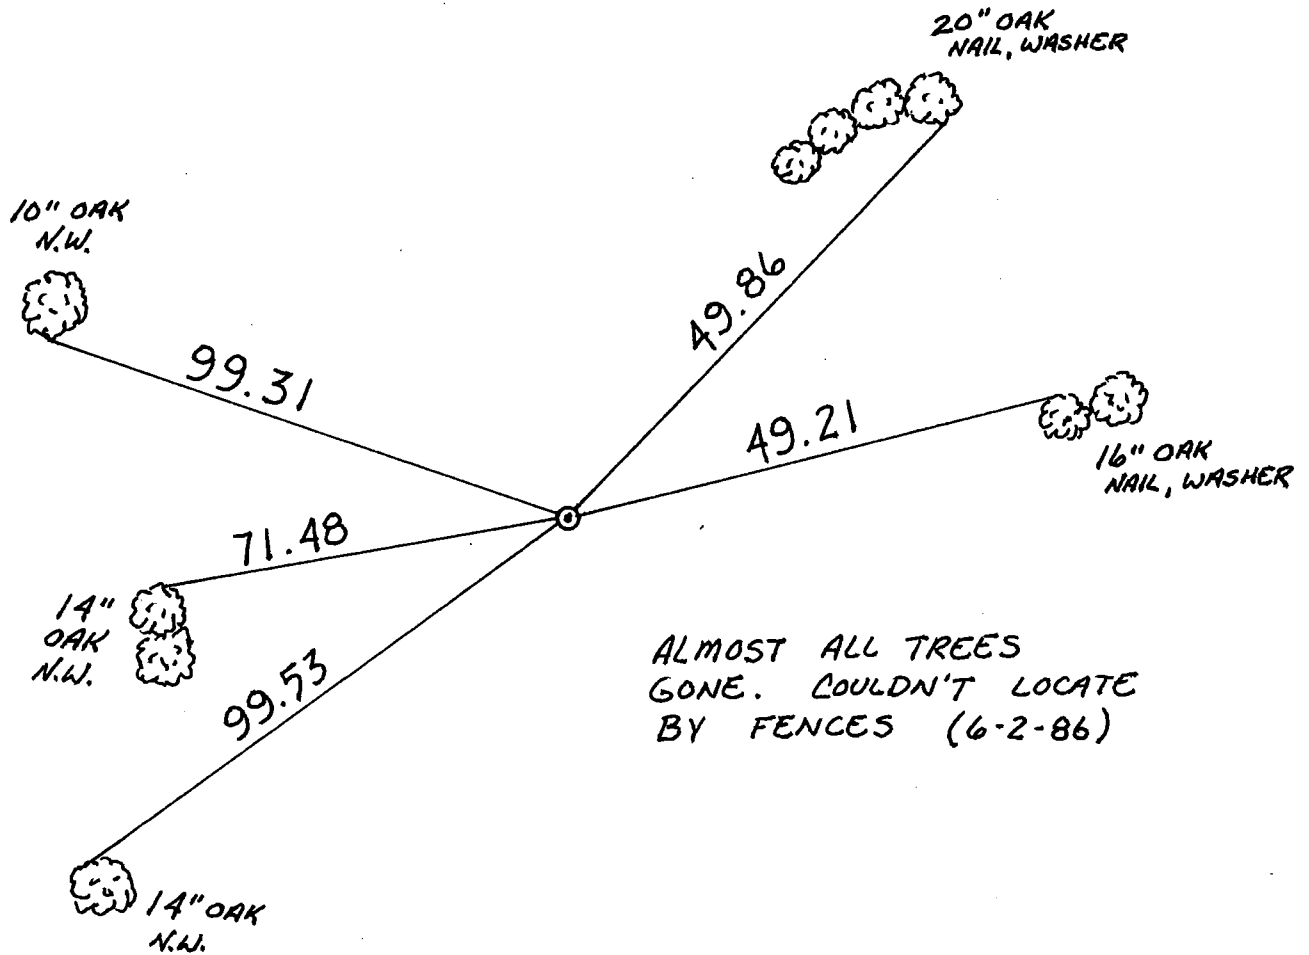

Revised date	Revised date	Revised date

