

CERTIFICATE OF LOCATION OF GOVERNMENT CORNER

County of Anoka


State of Minnesota

CENTER Corner of Sec. 29 Township 31 Range 23

I hereby certify that on the 6 day of MAY, 1963, I found the described corner which was evidenced by 1/2" I.P.

and I further certify that to perpetuate the location of said corner, I did, at the exact location thereof, place a permanent marker consisting of SAME
UNDER BLTP.

which reference or witness monuments are located in the manner following:

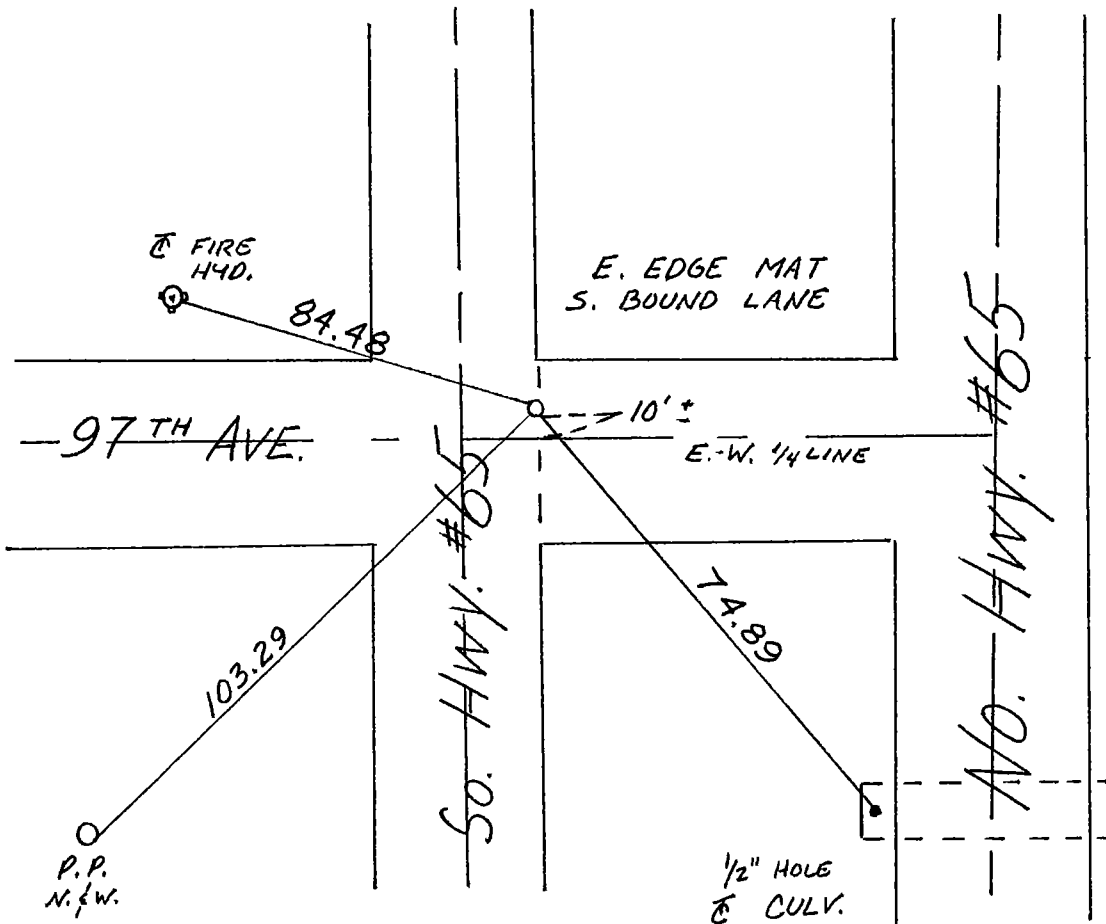

Revised date	Revised date	Revised date
10-24-90		
10-24-90 HL		

