

CERTIFICATE OF LOCATION OF GOVERNMENT CORNER

County of Anoka

State of Minnesota


Southwest Corner of Sec. 27 Township 31 Range 23

On the 8th day of November, 1961, the described corner was evidenced by a 1/2" iron pipe

and to perpetuate the location of said corner, at the exact location thereof, a permanent marker was placed consisting of a cast iron monument

AND on the 20th day of June, 2014, said permanent marker was found and raised to surface and the ties were updated

Updated reference ties are as shown below.

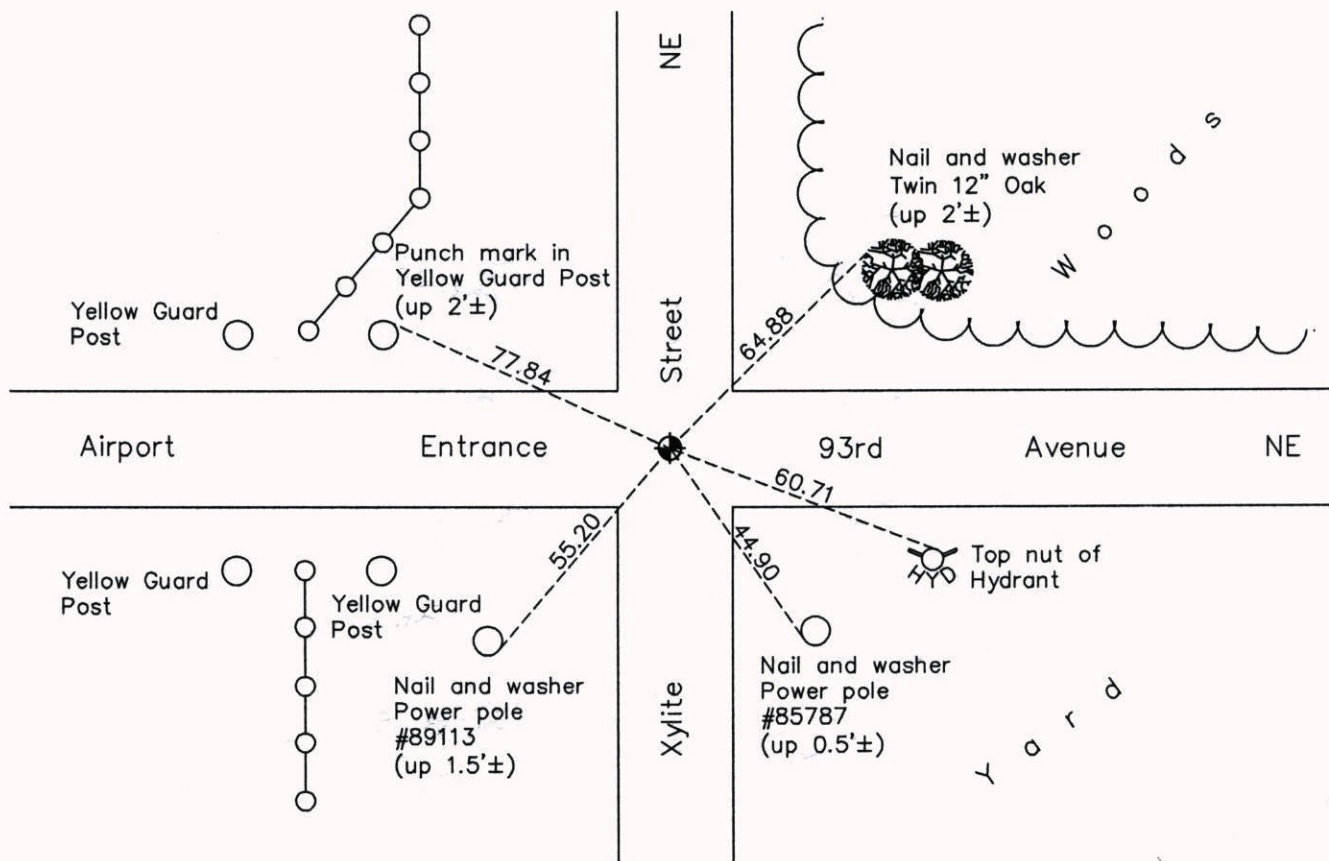

N

W ANOKA COUNTY SURVEYOR E

S

Revision Date

2/27/15

N.A.D. 1983 Coordinates
(1996 Adjustment)

County Project Coordinates	
Northing	137827.5679
Easting	515996.7102
Date	7/08/99

I hereby certify that this United States public land survey monument record is correct and complete to the best of my knowledge and belief.

Larry D. Hoium Date 2/27/15

Larry D. Hoium, Anoka County Surveyor

Minnesota License Number 18165