

CERTIFICATE OF LOCATION OF GOVERNMENT CORNER

County of Anoka

State of Minnesota


Northwest Corner of Sec. 33 Township 31 Range 23

On the 7th day of November, 1961, the described corner was evidenced by an iron spike

and to perpetuate the location of said corner, at the exact location thereof, a permanent marker was placed consisting of a cast iron monument

AND on the 9th day of June, 2014, said permanent marker was found with a sign and post on the north side and the ties were updated

Updated reference ties are as shown below.

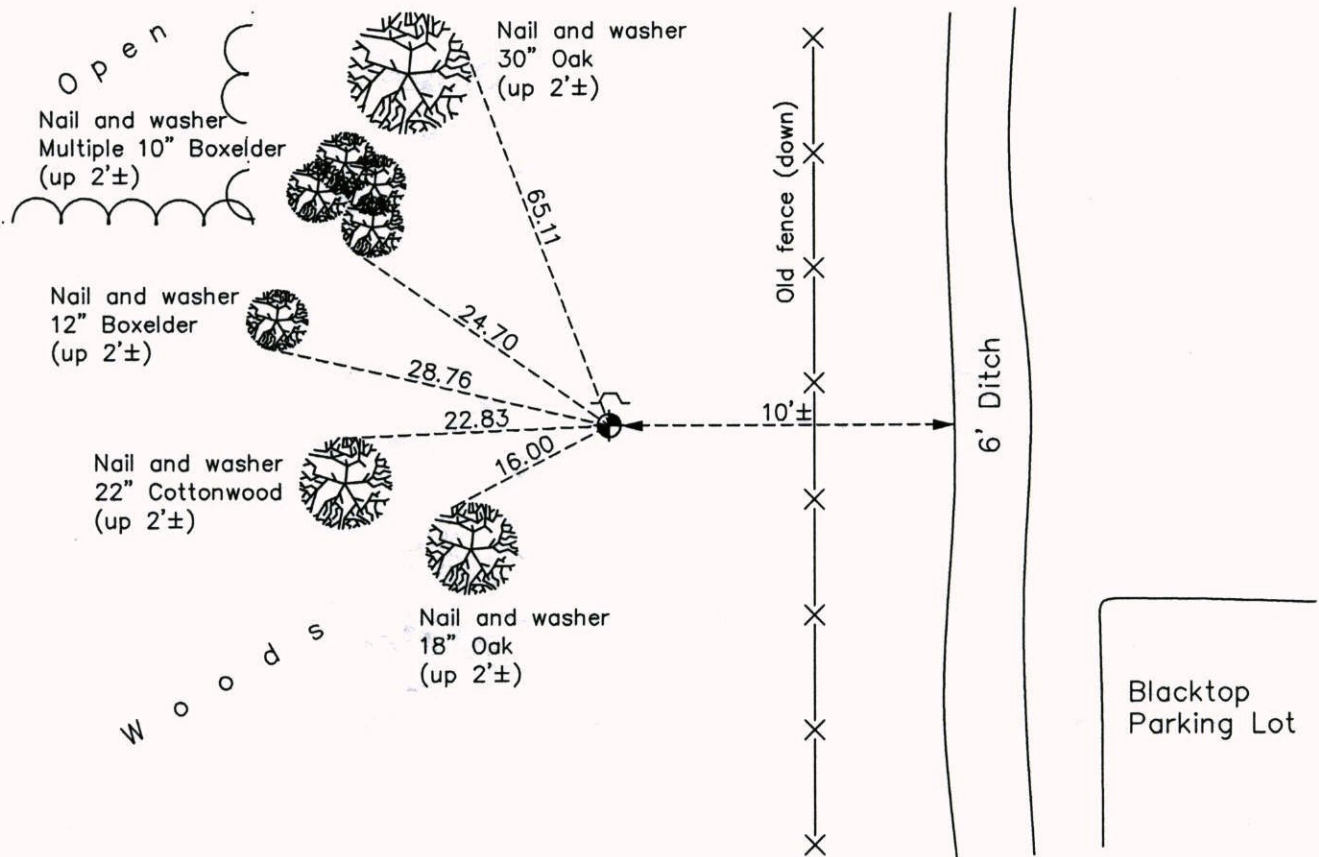

Revision Date
3/03/15

N.A.D. 1983 Coordinates
(1996 Adjustment)

County Project Coordinates	
Northing	<u>137847.6031</u>
Easting	<u>510701.9384</u>
Date	<u>7/08/99</u>

I hereby certify that this United States public land survey monument record is correct and complete to the best of my knowledge and belief.

Larry D. Hoium Date 3/03/15

Larry D. Hoium, Anoka County Surveyor

Minnesota License Number 18165