

CERTIFICATE OF LOCATION OF GOVERNMENT CORNER

County of Anoka

State of Minnesota


Northeast Corner of Sec. 31 Township 31 Range 23

On the 19th day of December, 1960, the described corner was evidenced by a concrete monument

and to perpetuate the location of said corner, at the exact location thereof, a permanent marker was placed consisting of a cast iron monument

AND on the 18th day of June, 2014, said permanent marker was found and the ties were updated

Updated reference ties are as shown below.

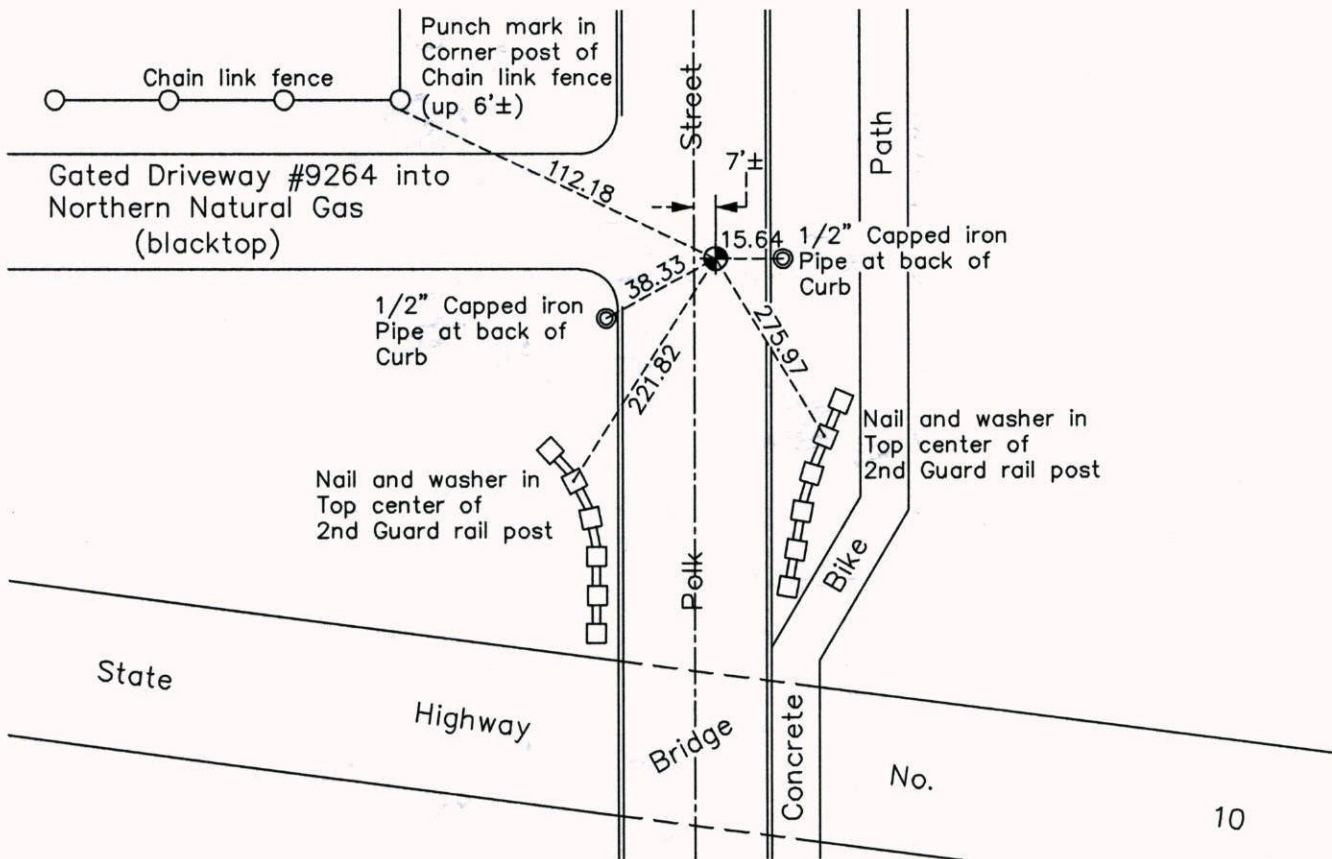

Revision Date
3/03/15

N.A.D. 1983 Coordinates
(1996 Adjustment)

County Project Coordinates	
Northing	137863.0786
Easting	505410.1241
Date	7/08/99

I hereby certify that this United States public land survey monument record is correct and complete to the best of my knowledge and belief.

Larry D. Hoium Date 3/03/15
 Larry D. Hoium, Anoka County Surveyor
 Minnesota License Number 18165