

# CERTIFICATE OF LOCATION OF GOVERNMENT CORNER

County of Anoka

State of Minnesota


## Northeast Corner of Sec. 3 Township 30 Range 23 (RAMSEY COUNTY MONUMENT)

On the 26th day of October, 1963, the described corner was evidenced by a granite monument

and to perpetuate the location of said corner, at the exact location thereof, a permanent marker was placed consisting of a cast iron monument

AND on the 17th day of July, 2014, said permanent marker was found and the ties were updated

Updated reference ties are as shown below.

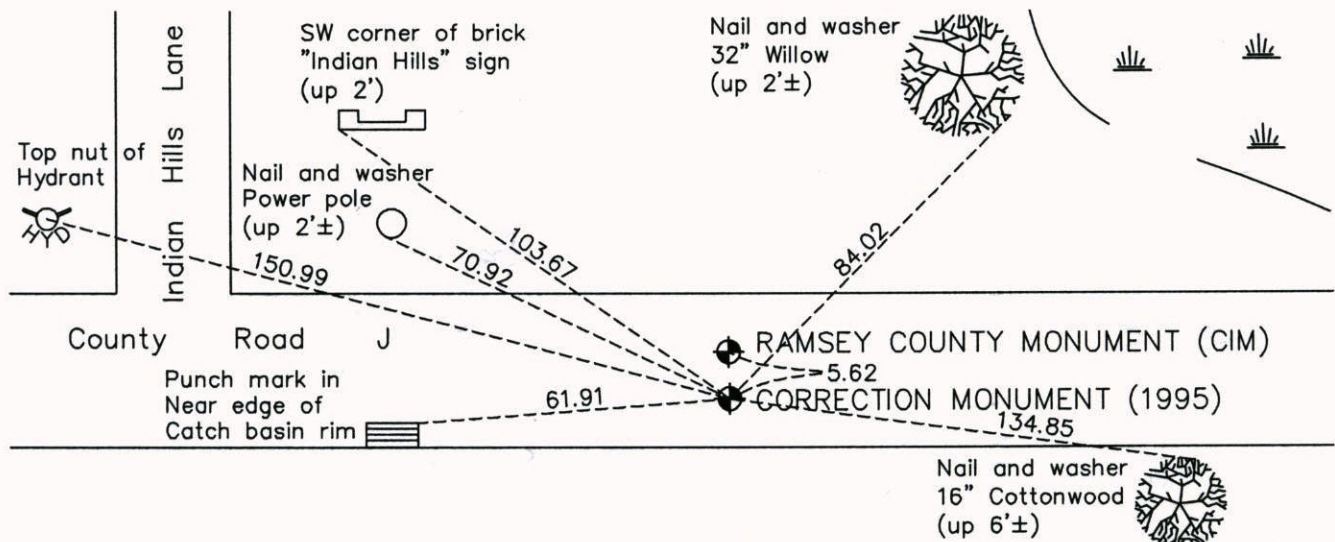

| Reference Ties and Coordinates for 'RAMSEY COUNTY MONUMENT' |  |  |                            |                             |                            |                      |
|---|--|--|----------------------------|-----------------------------|----------------------------|----------------------|
|   | <table border="1" style="width: 100%; border-collapse: collapse;"> <tr> <td style="text-align: center;">N.A.D. 1983 Coordinates<br/>(1996 Adjustment)</td> </tr> <tr> <td style="text-align: center;">County Project Coordinates</td> </tr> <tr> <td>Northing <u>132456.0165</u></td> </tr> <tr> <td>Easting <u>530654.0093</u></td> </tr> <tr> <td>Date <u>10/20/98</u></td> </tr> </table> | N.A.D. 1983 Coordinates<br>(1996 Adjustment) | County Project Coordinates | Northing <u>132456.0165</u> | Easting <u>530654.0093</u> | Date <u>10/20/98</u> |



Revision Date

3/05/15

### 'CORRECTION MONUMENT (1995)'

N.A.D. 1983 Coordinates  
(1996 Adjustment)

|                             |
|-----------------------------|
| County Project Coordinates  |
| Northing <u>132450.2762</u> |
| Easting <u>530654.1274</u>  |
| Date <u>10/19/98</u>        |

I hereby certify that this United States public land survey monument record is correct and complete to the best of my knowledge and belief.

Date 3/05/15  
 Larry D. Hoium, Anoka County Surveyor  
 Minnesota License Number 18165