

CERTIFICATE OF LOCATION OF GOVERNMENT CORNER

County of Anoka

State of Minnesota


Southwest Corner of Sec. 36 Township 31 Range 23

On the 11th day of July, 1963, the described corner was evidenced by area resurvey

and to perpetuate the location of said corner, at the exact location thereof, a permanent marker was placed consisting of a 1/2" iron pipe in concrete apron

AND on the 16th day of July, 2014, said permanent marker was found and the ties were updated

Updated reference ties are as shown below.

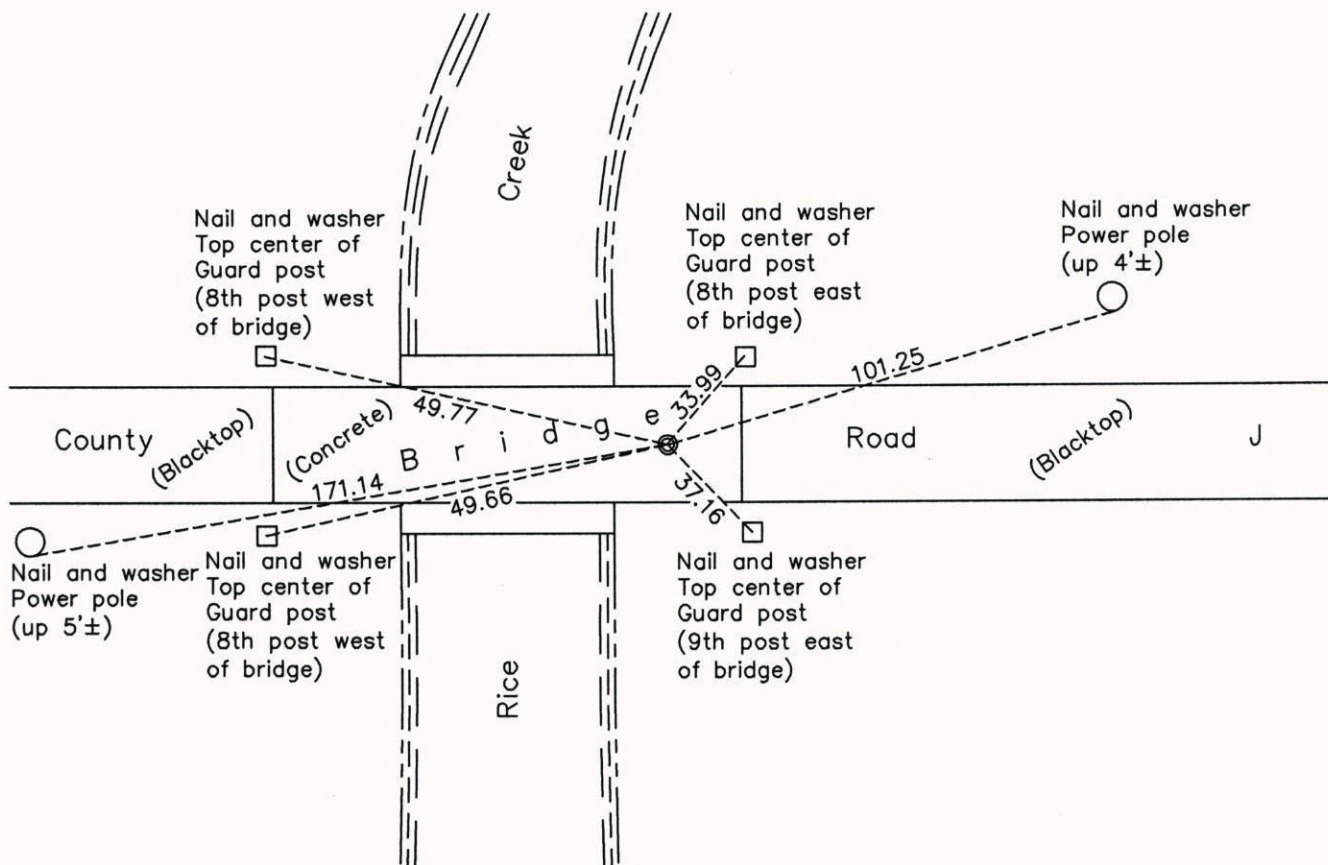

Revision Date

3/09/15

N.A.D. 1983 Coordinates
(1996 Adjustment)

County Project Coordinates

Northing 132465.2105

Easting 526558.3358

Date 10/19/98

I hereby certify that this United States public land survey monument record is correct and complete to the best of my knowledge and belief.

Larry D. Hoium Date 3/09/15

Larry D. Hoium, Anoka County Surveyor

Minnesota License Number 18165