

CERTIFICATE OF LOCATION OF GOVERNMENT CORNER

County of Anoka

State of Minnesota


Witness Corner of Sec. 1 Township 32 Range 22
 (on north line of NE 1/4)

On the 22nd day of October, 1986, the described corner was evidenced by area resurvey

and to perpetuate the location of said corner, at the exact location thereof, a permanent marker was placed consisting of a cast iron monument

AND on the 7th day of October, 2014, said permanent marker was found down 0.2'±.
Raised CIM to flush with the surface and updated ties on October 10, 2014.

Updated reference ties are as shown below.

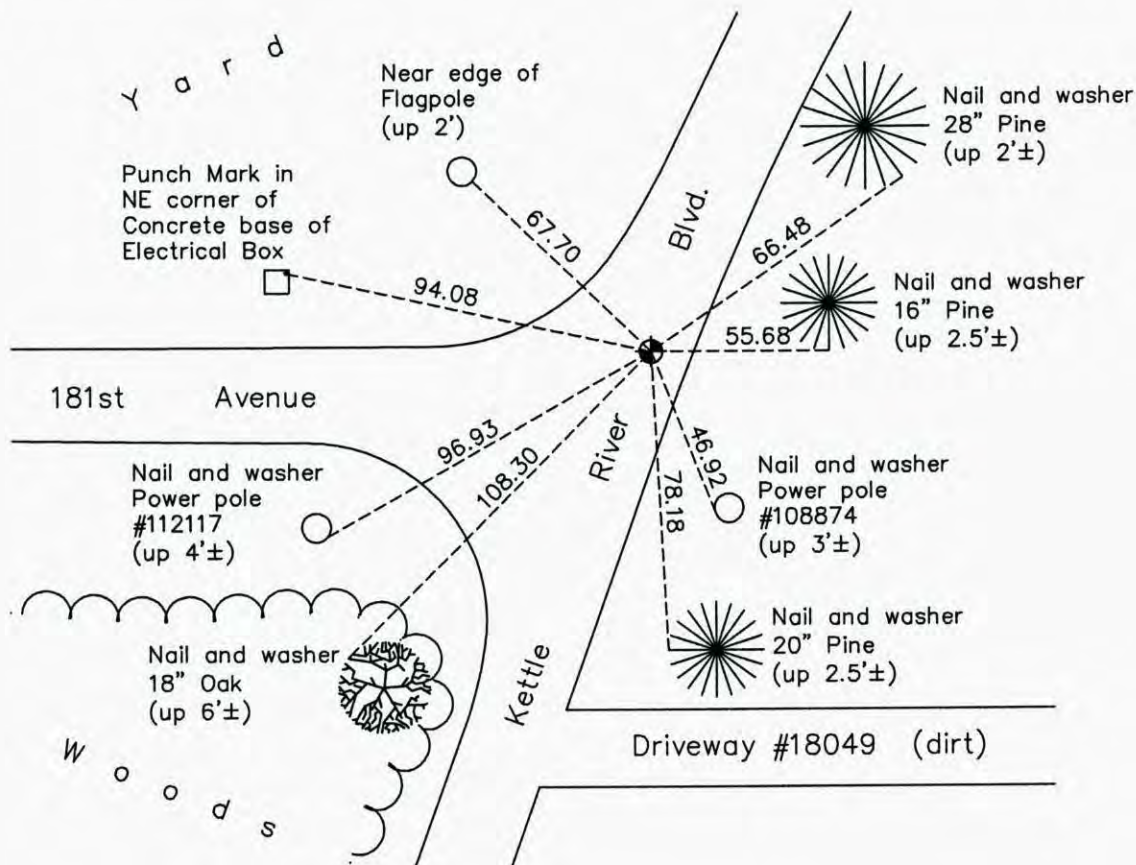

N
▲
 W ANOKA COUNTY SURVEYOR E
▼
 S

Revision Date
4/15/15

N.A.D. 1983 Coordinates
(1996 Adjustment)

County Project Coordinates	
Northing	<u>195504.8475</u>
Easting	<u>561479.9004</u>
Date	<u>6/16/03</u>

I hereby certify that this United States public land survey monument record is correct and complete to the best of my knowledge and belief.

Larry D. Hoium Date 4/15/15

Larry D. Hoium, Anoka County Surveyor
 Minnesota License Number 18165