

CERTIFICATE OF LOCATION OF GOVERNMENT CORNER

County of Anoka


State of Minnesota

1/16 COR. ON NORTH Corner of Sec. 2 Township 32 Range 22
LINE OF NW 1/4

I hereby certify that on the 2 day of JUNE, 1971, I found the described corner which was evidenced by CONCRETE MONUMENT

and I further certify that to perpetuate the location of said corner, I did, at the exact location thereof, place a permanent marker consisting of 1/2" IRON PIPE

which reference or witness monuments are located in the manner following:

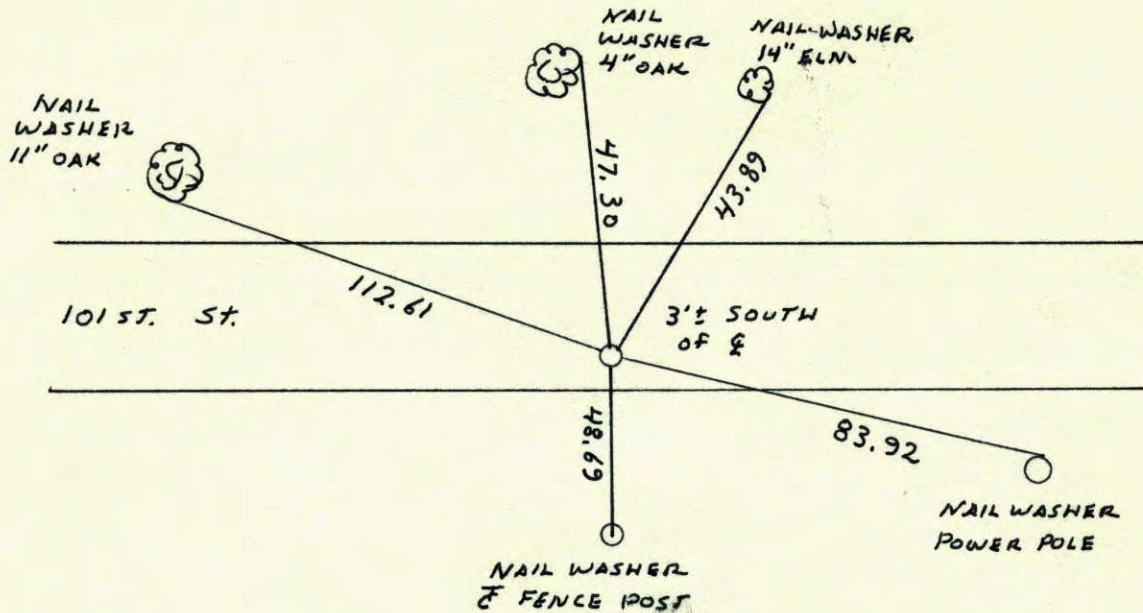

Revised date

8-13-85
REDRAWN
2-3-88
6-14-89

By

D. ROSS
H. LARSON

Minnesota State Plane Coordinates
South Zone

Y _____ X _____

County Surveyor _____

Date _____

Registered Land Surveyor No. _____