

# CERTIFICATE OF LOCATION OF GOVERNMENT CORNER

County of Anoka

State of Minnesota



North 1/4 Corner of Sec. 5 Township 32 Range 22

On the 2nd day of February, 1977, the described corner was evidenced by a concrete monument

and to perpetuate the location of said corner, at the exact location thereof, a permanent marker was placed consisting of the same concrete monument

AND on the 30th day of January, 2006, said permanent marker was found with the top 0.2' of the concrete monument broken off. The ties were updated.

Updated reference ties are as shown below.

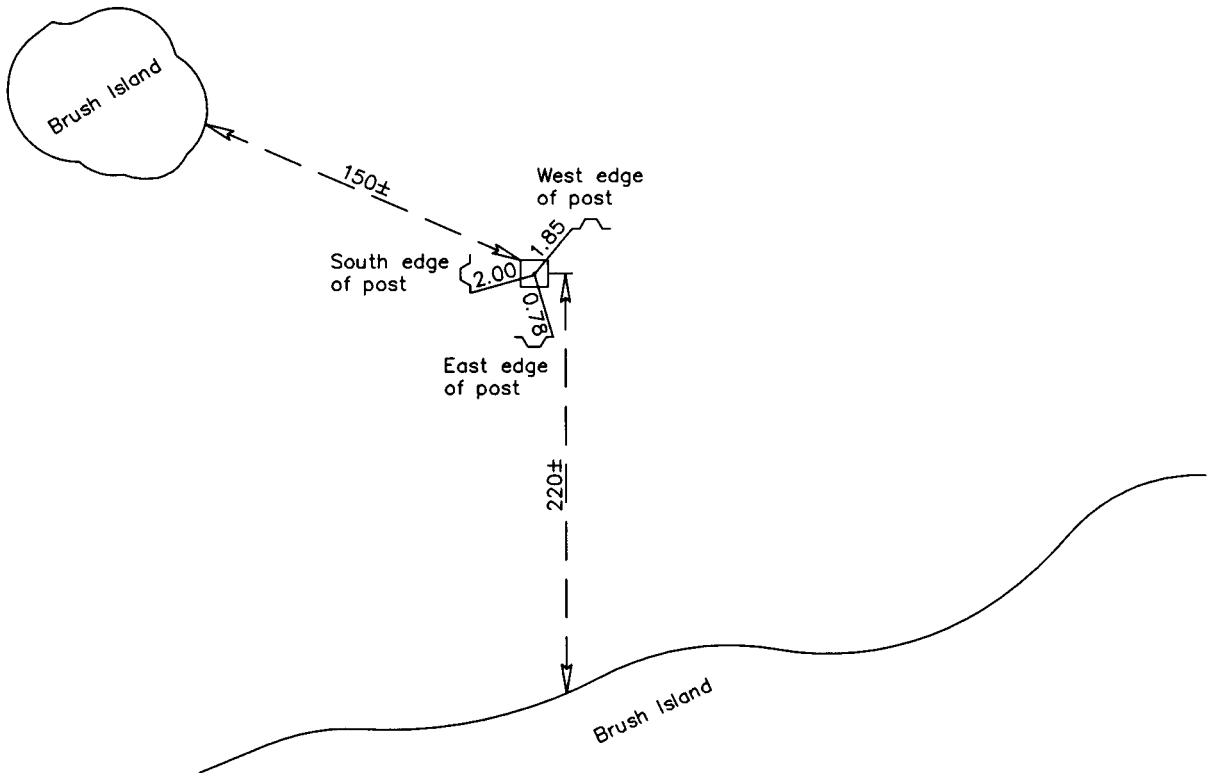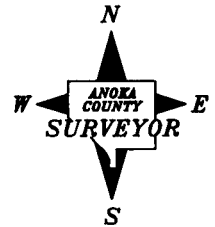

Revised date

1985
1995
1/30/06

N.A.D. 1983 Coordinates  
(1996 Adjustment)

County Project Coordinates	
Northing	195543.1900
Easting	539961.0565
Date	1/30/06

I hereby certify that this United States public land survey monument record is correct and complete to the best of my knowledge and belief.

*Larry D. Hoium* Date 1/30/06

\_\_\_\_\_  
Larry D. Hoium, Anoka County Surveyor

Minnesota License Number 18165