

# CERTIFICATE OF LOCATION OF GOVERNMENT CORNER

County of Anoka


State of Minnesota

WEST 1/16 of the Corner of Sec. 5 Township 32 Range 22  
NORTH EAST 1/4

I hereby certify that on the 4 day of FEB., 1977, I found the described corner which was evidenced by Concrete

and I further certify that to perpetuate the location of said corner, I did, at the exact location thereof, place a permanent marker consisting of Concrete monument  
SIGN and Post on north side

which reference or witness monuments are located in the manner following:

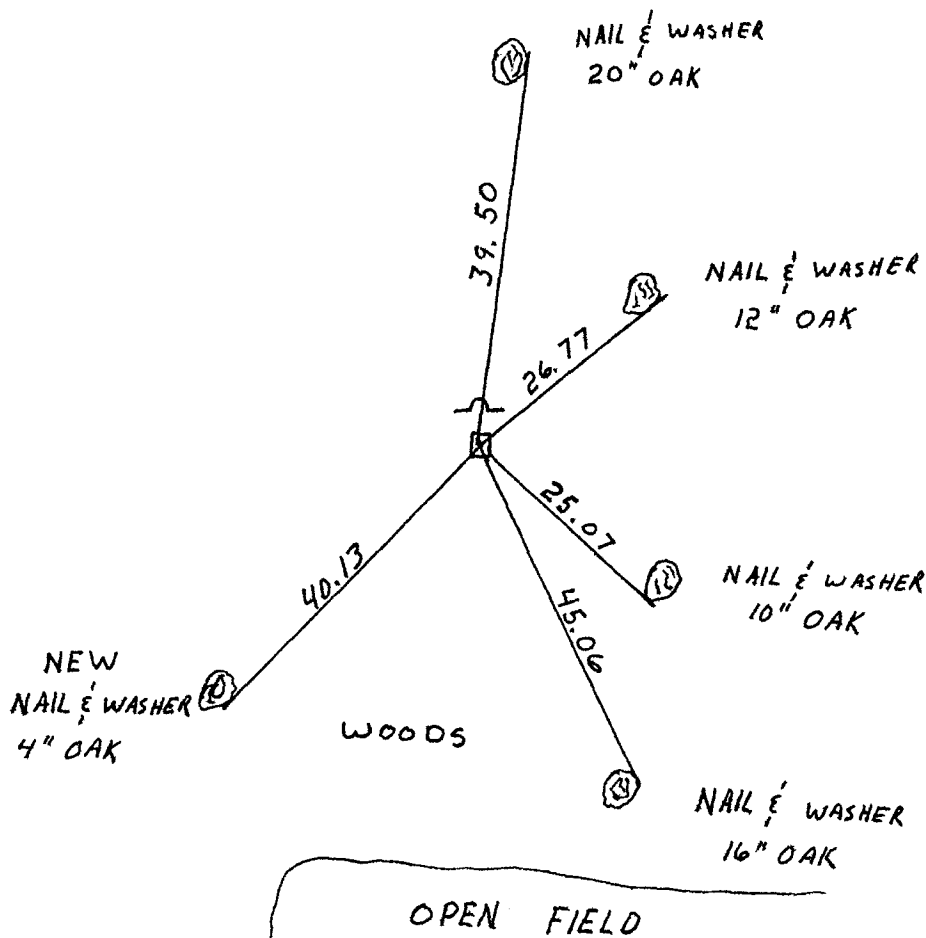

Revised date	Revised date	Revised date
8-8-79		
7-28-82		
WINTER ACCESS -85		
7-13-90		

