

CERTIFICATE OF LOCATION OF GOVERNMENT CORNER

County of Anoka


State of Minnesota

CENTER Corner of Sec. 2 Township 33 Range 22

I hereby certify that on the 23 day of SEPT, 1969, I found the described corner which was evidenced by TIES BY J. KURTH

and I further certify that to perpetuate the location of said corner, I did, at the exact location thereof, place a permanent marker consisting of 3/4" IRON PIPE

which reference or witness monuments are located in the manner following:

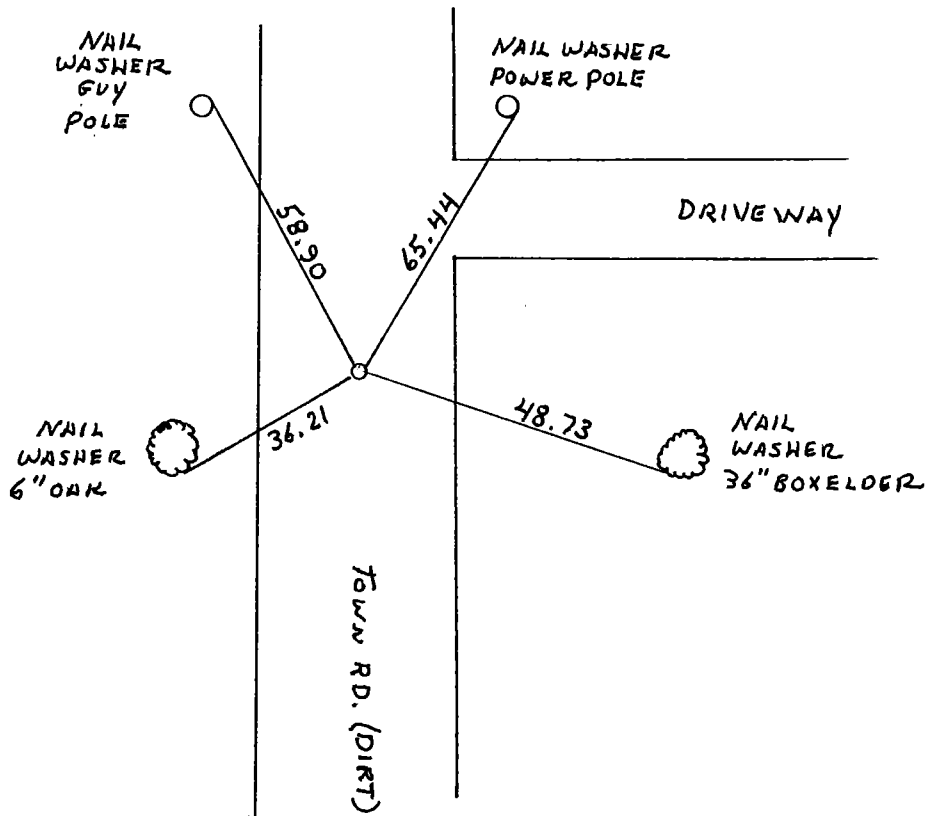

Revised date	Revised date	Revised date
8-23-69		
6-5-73		
9-5-76		
7-9-82		
8-13-85		
REDRAWN 5-8-87 HL		

