

# CERTIFICATE OF LOCATION OF GOVERNMENT CORNER

County of Anoka

State of Minnesota


## Southwest Corner of Sec. 1 Township 32 Range 22

On the 27th day of December, 1968, the described corner was evidenced by a 3/4" iron pipe

and to perpetuate the location of said corner, at the exact location thereof, a permanent marker was placed consisting of a cast iron monument with a sign and post on the north side

AND on the 9th day of October, 2014, said permanent marker was found and the ties were updated. The sign was found missing. Set new sign and post on the east side.

Updated reference ties are as shown below.

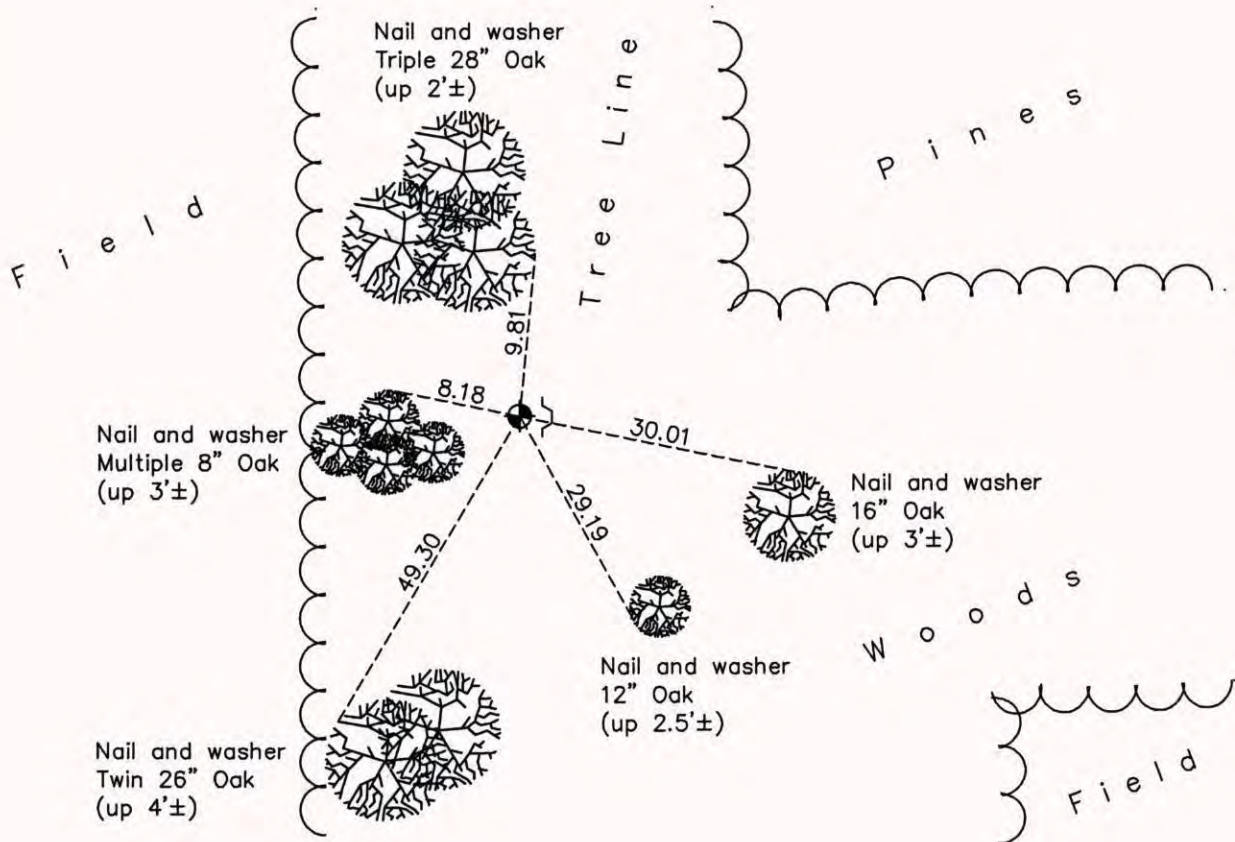

Revision Date  
5/07/15

N.A.D. 1983 Coordinates  
(1996 Adjustment)

County Project Coordinates	
Northing	<u>190403.1786</u>
Easting	<u>558390.5046</u>
Date	<u>4/18/05</u>

I hereby certify that this United States public land survey monument record is correct and complete to the best of my knowledge and belief.

*Larry D. Hoium* Date 5/07/15

Larry D. Hoium, Anoka County Surveyor

Minnesota License Number 18165