

CERTIFICATE OF LOCATION OF GOVERNMENT CORNER

County of Anoka

State of Minnesota


South 1/4 Corner of Sec. 4 Township 32 Range 22

On the 12th day of February, 1974, the described corner was evidenced by a concrete monument

and to perpetuate the location of said corner, at the exact location thereof, a permanent marker was placed consisting of the same concrete monument

AND on the 11th day of December, 2014, said permanent marker was found up 0.1'± above ice and leaning northwesterly 0.4'±. The ties were updated.

Updated reference ties are as shown below.

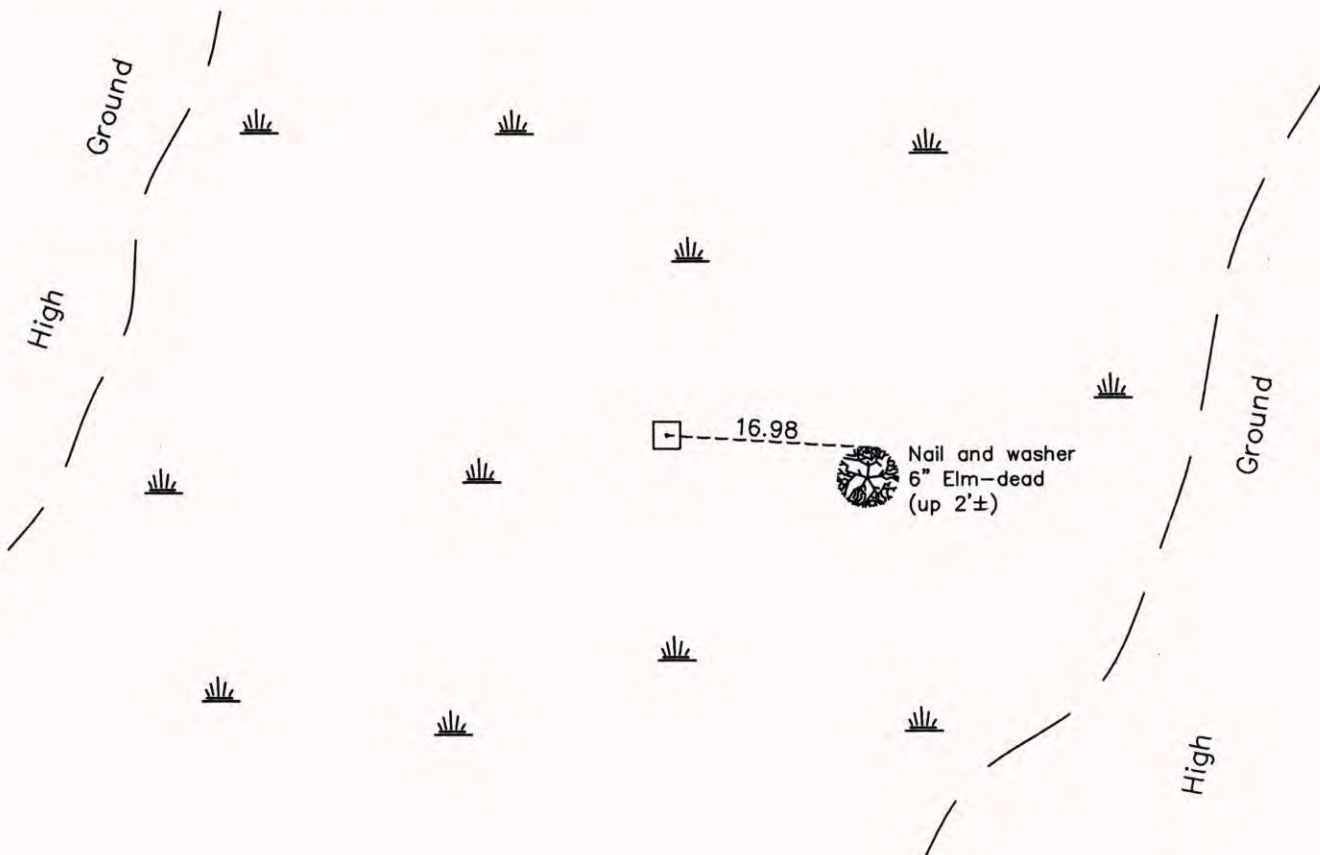

Revision Date

5/11/15

N.A.D. 1983 Coordinates
(1996 Adjustment)

County Project Coordinates

Northing 190457.2984

Easting 545302.6315

Date 5/04/05

I hereby certify that this United States public land survey monument record is correct and complete to the best of my knowledge and belief.

Larry D. Hoium Date 5/11/15

Larry D. Hoium, Anoka County Surveyor

Minnesota License Number 18165