

CERTIFICATE OF LOCATION OF GOVERNMENT CORNER

County of Anoka

State of Minnesota

Northwest Corner of Sec. 9 Township 32 Range 22



On the 16th day of March, 1977, the described corner was evidenced by a concrete monument

and to perpetuate the location of said corner, at the exact location thereof, a permanent marker was placed consisting of the same concrete monument

AND on the 4th day of May, 2005, said permanent marker was found laying down.

The concrete monument was straightened up and the ties were updated.

Updated reference ties are as shown below.

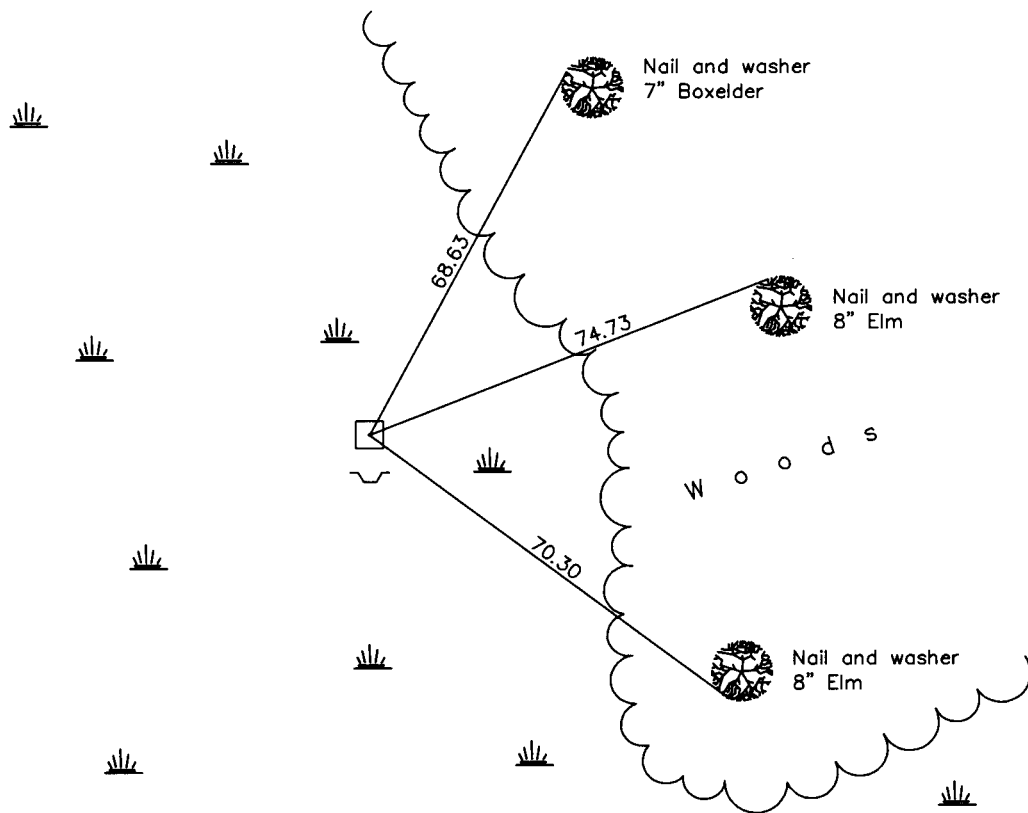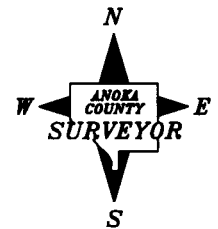

Revised date

1995
5/04/05

N.A.D. 1983 Coordinates
(1996 Adjustment)

County Project Coordinates
Northing <u>190463.0578</u>
Easting <u>542660.0675</u>
Date <u>5/04/05</u>

I hereby certify that this United States public land survey monument record is correct and complete to the best of my knowledge and belief.

Larry D. Hoium Date 5/04/05
 _____, Anoka County Surveyor
 Minnesota License Number 18165