

CERTIFICATE OF LOCATION OF GOVERNMENT CORNER

County of Anoka


State of Minnesota

S. 16TH OF S.E. 1/4 Corner of Sec. 6 Township 32 Range 22

I hereby certify that on the 17 day of MAR., 19 77, I found the described corner which was evidenced by CONCRETE MONUMENT

and I further certify that to perpetuate the location of said corner, I did, at the exact location thereof, place a permanent marker consisting of CONCRETE MON.

which reference or witness monuments are located in the manner following:

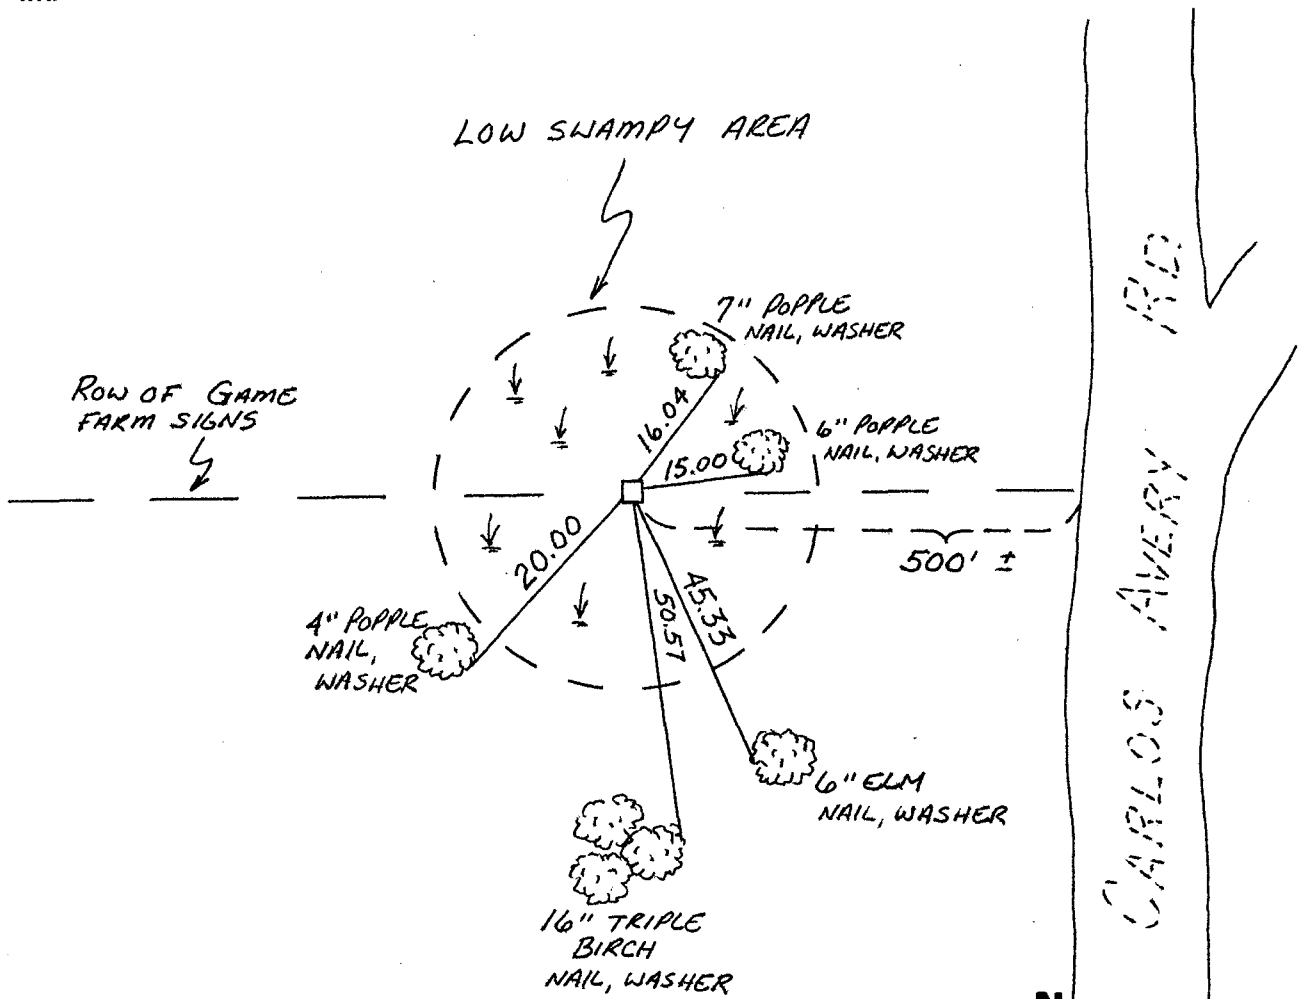

Revised date	Revised date	Revised date
7-9-82		

