

# CERTIFICATE OF LOCATION OF GOVERNMENT CORNER

County of Anoka

State of Minnesota


## Southeast Corner of Sec. 12 Township 32 Range 22

On the 3rd day of August, 1964, the described corner was evidenced by a sandstone monument

and to perpetuate the location of said corner, at the exact location thereof, a permanent marker was placed consisting of a Washington County cast iron monument

AND on the 23rd day of September, 2014, said permanent marker was found up 0.5'± and the ties were updated

Updated reference ties are as shown below.

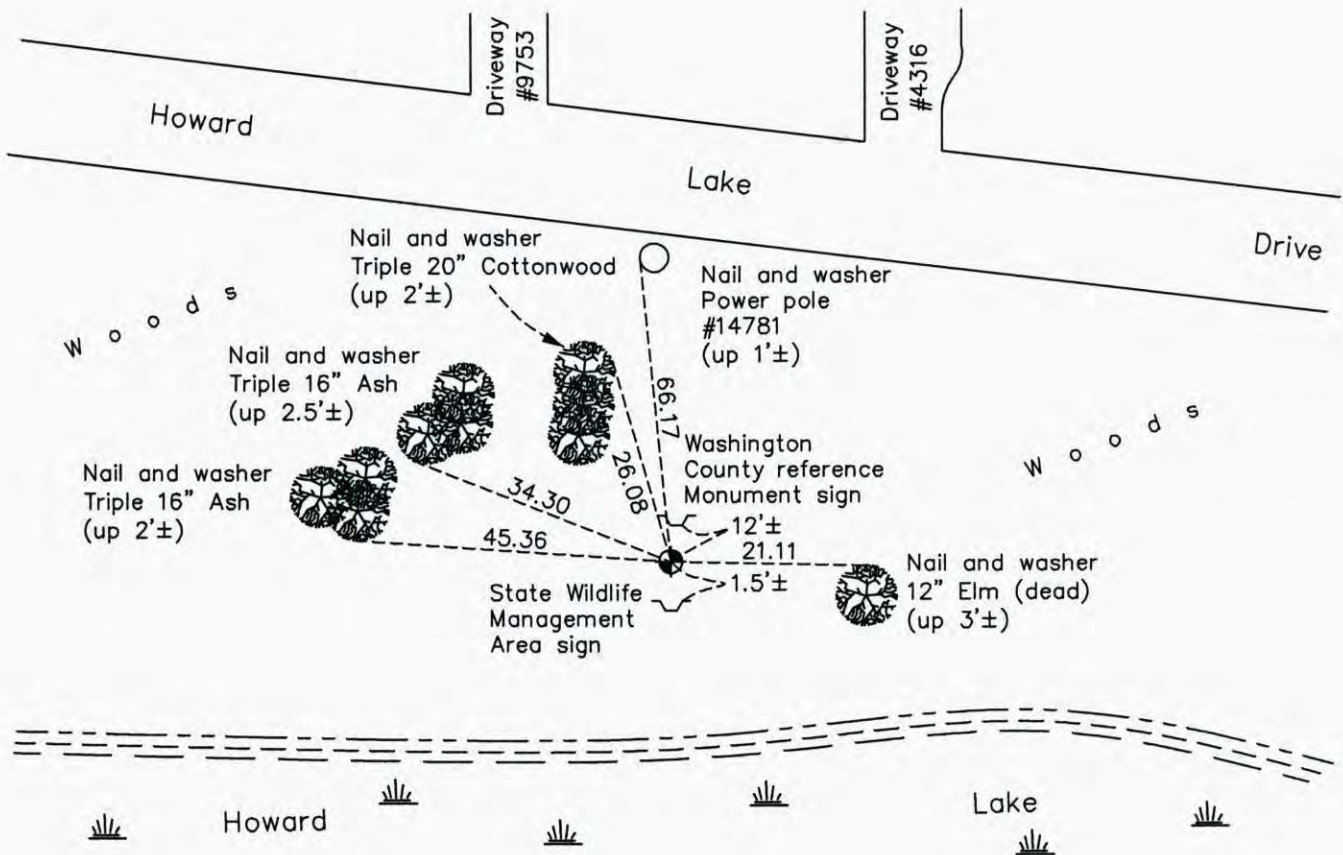

N  
W ANOKA COUNTY SURVEYOR E  
S

Revision Date  
5/20/15

N.A.D. 1983 Coordinates  
(1996 Adjustment)

County Project Coordinates	
Northing	185097.6006
Easting	563624.7681
Date	7/01/03

I hereby certify that this United States public land survey monument record is correct and complete to the best of my knowledge and belief.

*Larry D. Hoium* Date 5/20/15

Larry D. Hoium, Anoka County Surveyor  
Minnesota License Number 18165