

CERTIFICATE OF LOCATION OF GOVERNMENT CORNER

County of Anoka

State of Minnesota


North 1/4 Corner of Sec. 13 Township 32 Range 22

On the 14th day of February, 1979, the described corner was evidenced by a 2" iron pipe

and to perpetuate the location of said corner, at the exact location thereof, a permanent marker was placed consisting of a red and white iron pipe

AND on the 17th day of December, 2014, said permanent marker was found to be a 2" square steel Telspar monument up 1'± with a sign attached facing north. The ties were updated.

Updated reference ties are as shown below.

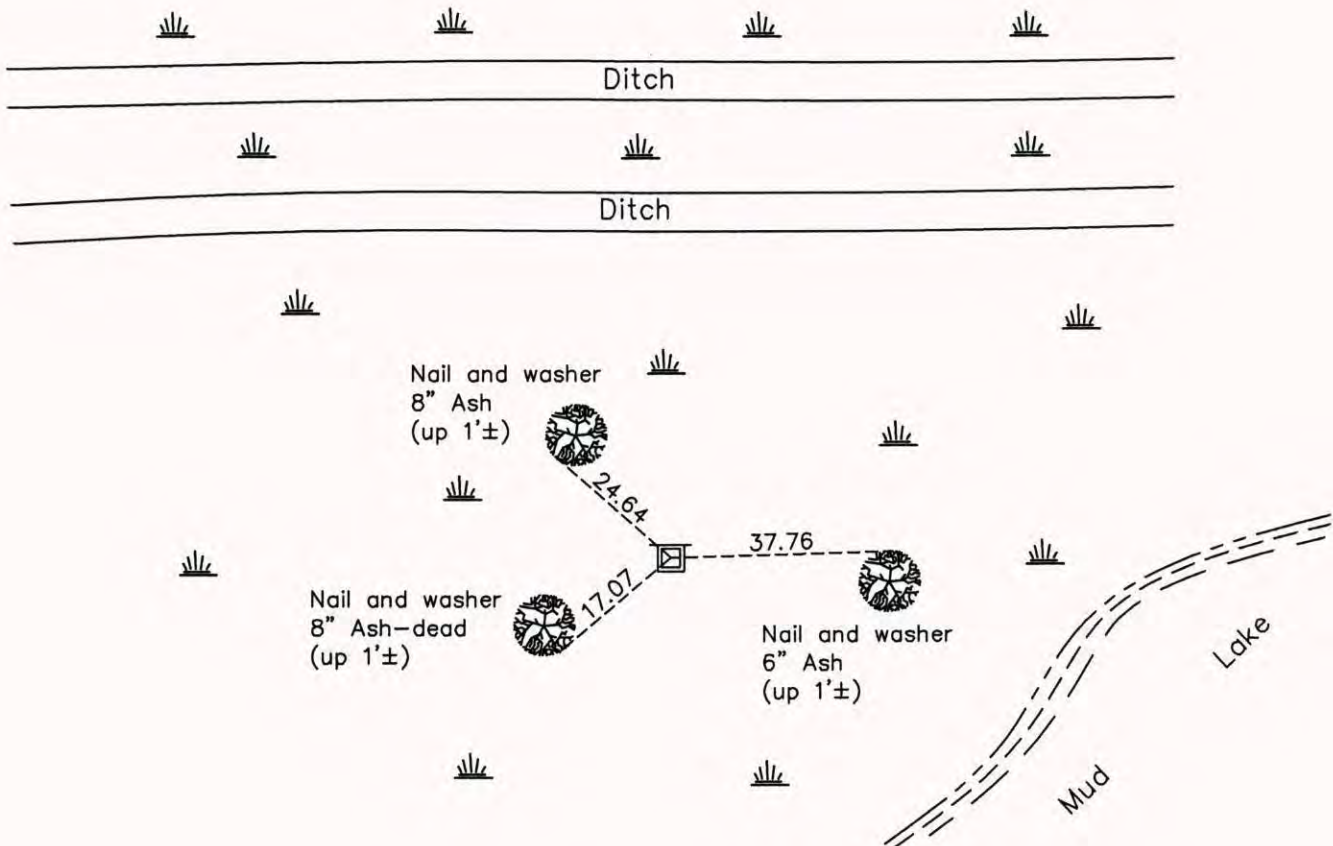

Revision Date
5/20/15

N.A.D. 1983 Coordinates
(1996 Adjustment)

County Project Coordinates	
Northing	185122.4252
Easting	561015.4990
Date	1/11/06

I hereby certify that this United States public land survey monument record is correct and complete to the best of my knowledge and belief.

Larry D. Hoium Date 5/20/15

Larry D. Hoium, Anoka County Surveyor
Minnesota License Number 18165