

# CERTIFICATE OF LOCATION OF GOVERNMENT CORNER

County of Anoka

State of Minnesota


Witness Corner of Sec. 22 Township 32 Range 22  
 (on east line of NE 1/4)

On the 25th day of February, 1983, the described corner was evidenced by area resurvey

and to perpetuate the location of said corner, at the exact location thereof, a permanent marker was placed consisting of a 2" square steel Telespar monument with 'County Surveyor' cap and a sign and post on the north side

AND on the 14th day of October, 2014, said permanent marker was found and the ties  
were updated

Updated reference ties are as shown below.

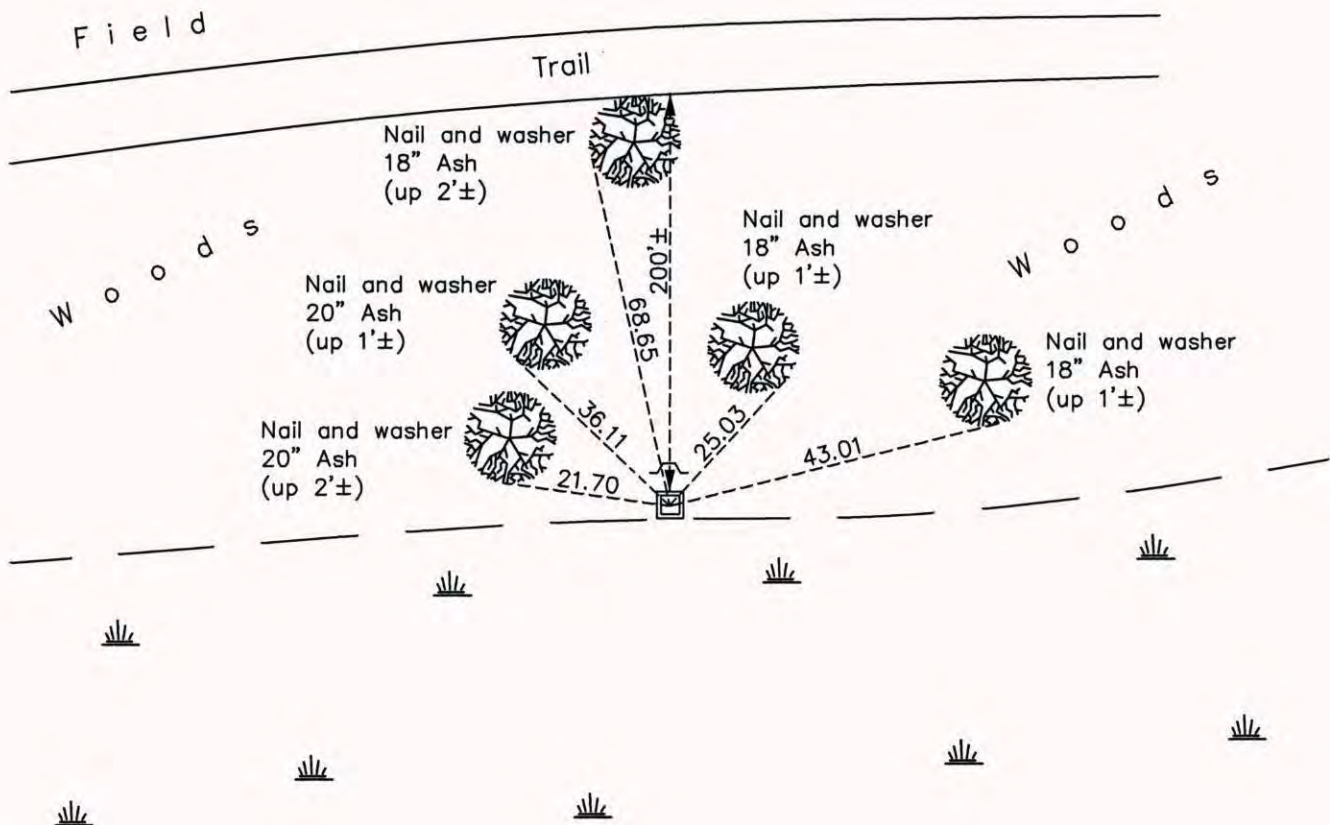

Revision Date  
6/29/15

N.A.D. 1983 Coordinates  
 (1996 Adjustment)

County Project Coordinates	
Northing	178539.9413
Easting	553228.3416
Date	2/14/06

I hereby certify that this United States public land survey monument record is correct and complete to the best of my knowledge and belief.

*Larry D. Hoium* Date 6/29/15

Larry D. Hoium, Anoka County Surveyor  
 Minnesota License Number 18165