

# CERTIFICATE OF LOCATION OF GOVERNMENT CORNER

County of Anoka

State of Minnesota


## Southwest Corner of Sec. 24 Township 32 Range 22

On the 20th day of July, 1972, the described corner was evidenced by area resurvey

and to perpetuate the location of said corner, at the exact location thereof, a permanent marker was placed consisting of a 2" square steel Telespar monument with 'Anoka County' cap on top

AND on the 15th day of December, 2014, said permanent marker was found with a sign and post on the north side and the ties were updated

Updated reference ties are as shown below.

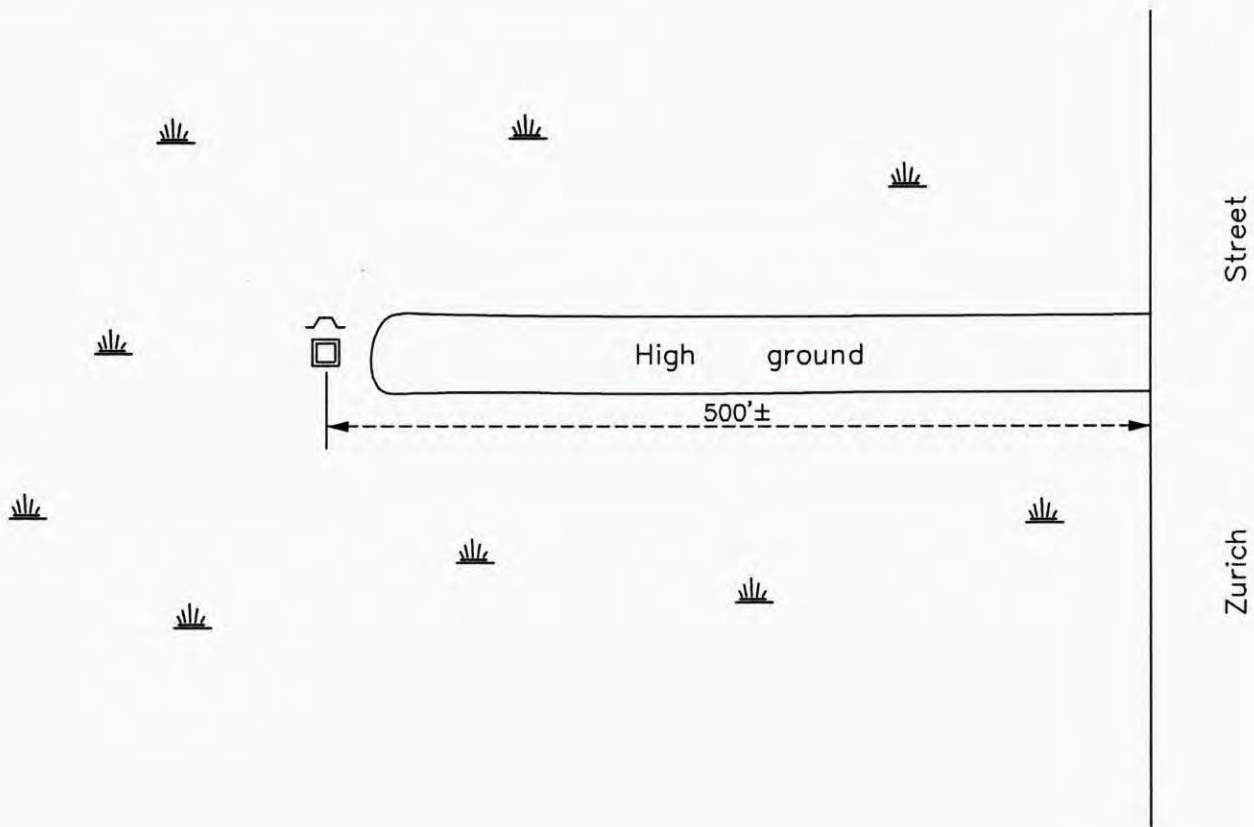

Revision Date

7/01/15

N.A.D. 1983 Coordinates  
(1996 Adjustment)

County Project Coordinates

Northing 174635.4729

Easting 558412.7768

Date 1/18/06

I hereby certify that this United States public land survey monument record is correct and complete to the best of my knowledge and belief.

*Larry D. Hoium* Date 7/01/15

Larry D. Hoium, Anoka County Surveyor

Minnesota License Number 18165