

# CERTIFICATE OF LOCATION OF GOVERNMENT CORNER

County of Anoka

State of Minnesota


## South 1/4 Corner of Sec. 21 Township 32 Range 22

On the \_\_\_\_ day of July, 1967, the described corner was evidenced by an iron pipe

and to perpetuate the location of said corner, at the exact location thereof, a permanent marker was placed consisting of a cast iron monument with a sign and post on the north side

AND on the 15th day of October, 2014, said permanent marker was found up 0.2'± and the ties were updated

Updated reference ties are as shown below.

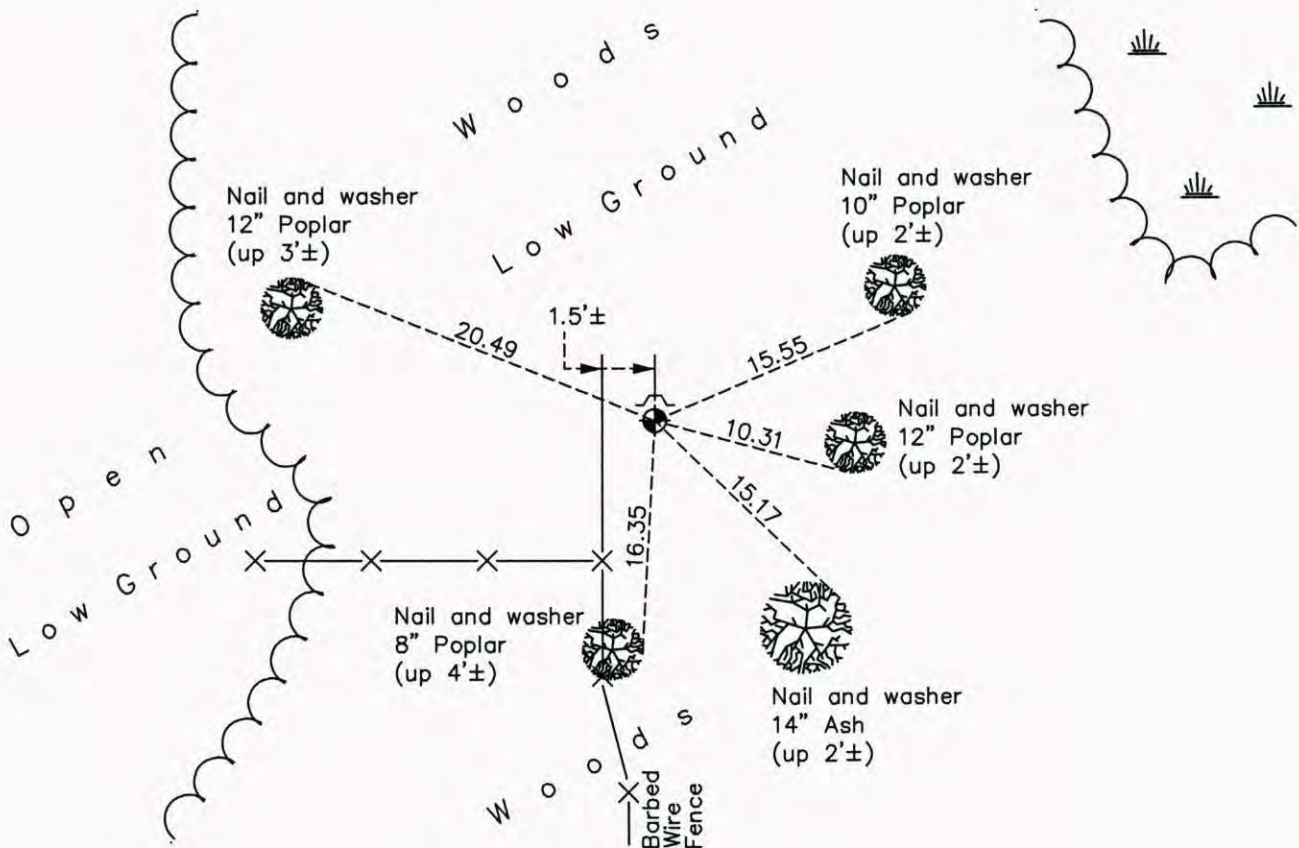

Revision Date  
7/09/15

N.A.D. 1983 Coordinates  
(1996 Adjustment)

County Project Coordinates	
Northing	174664.2036
Easting	545300.2203
Date	3/20/03

I hereby certify that this United States public land survey monument record is correct and complete to the best of my knowledge and belief.

*Larry D. Hoium* Date 7/09/15

Larry D. Hoium, Anoka County Surveyor

Minnesota License Number 18165