

# CERTIFICATE OF LOCATION OF GOVERNMENT CORNER

County of Anoka

State of Minnesota


## West 1/4 Corner of Sec. 25 Township 32 Range 22

On the 6th day of January, 1975, the described corner was evidenced by area resurvey

and to perpetuate the location of said corner, at the exact location thereof, a permanent marker was placed consisting of a red and white 2" square steel Telespar monument with a  
"County Surveyor" cap and a sign attached facing north

AND on the 5th day of March, 2015, said permanent marker was found up 3.5'± and  
leaning northerly 1'±. The ties were updated.

Updated reference ties are as shown below.

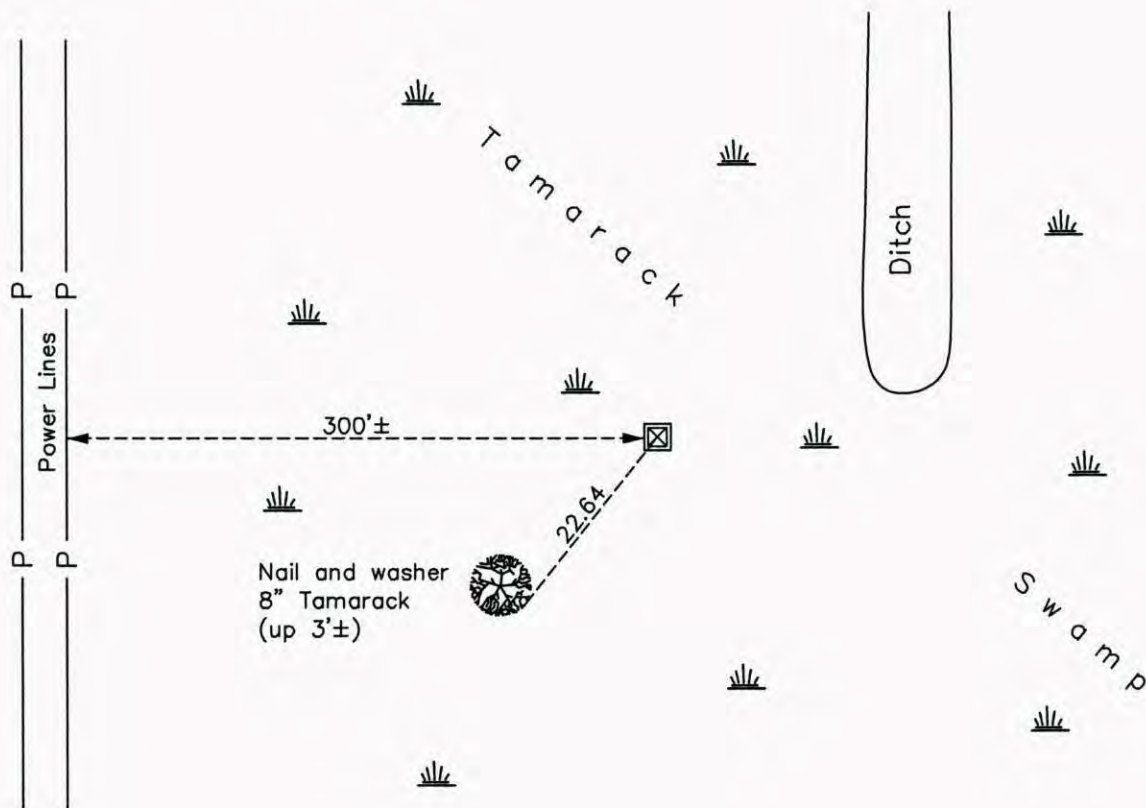

Revision Date  
7/13/15

N.A.D. 1983 Coordinates  
 (1996 Adjustment)

County Project Coordinates	
Northing	<u>172041.8771</u>
Easting	<u>558416.6972</u>
Date	<u>1/23/06</u>

I hereby certify that this United States public land survey monument record is correct and complete to the best of my knowledge and belief.

*Larry D. Hoium* Date 7/13/15

Larry D. Hoium, Anoka County Surveyor

Minnesota License Number 18165