

# CERTIFICATE OF LOCATION OF GOVERNMENT CORNER

County of Anoka

State of Minnesota

## Witness Corner of Sec. 28 Township 32 Range 22


(on south line of SE 1/4)

On the 1st day of January, 1998, the described corner was evidenced by area resurvey

and to perpetuate the location of said corner, at the exact location thereof, a permanent marker was placed consisting of a 1/2" iron pipe with a sign and post on the north side

AND on the 24th day of September, 2014, said permanent marker was found with an Anoka County cap and sign and post 1'± south of monument. The ties were updated.

Updated reference ties are as shown below.

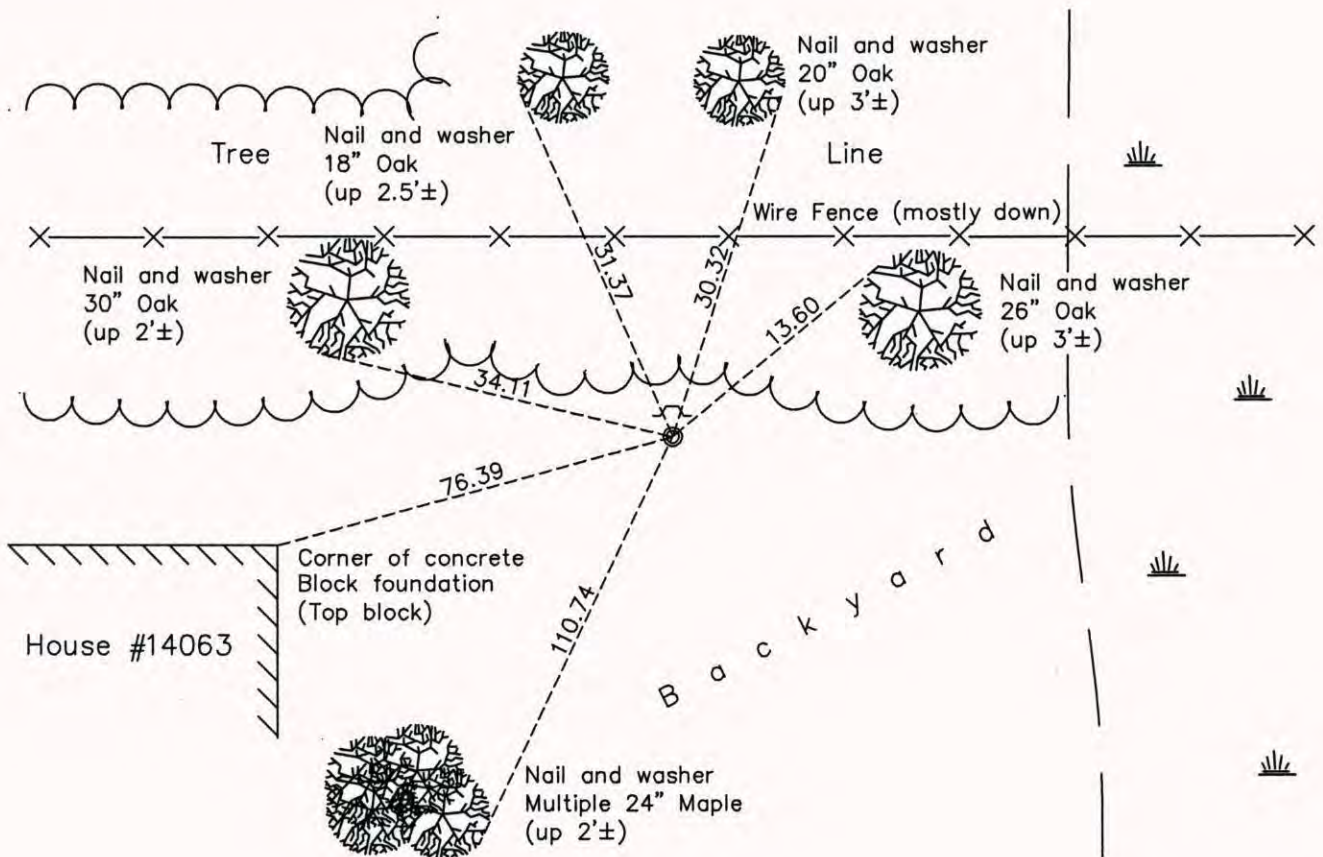

Revision Date  
7/20/15

N.A.D. 1983 Coordinates  
(1996 Adjustment)

County Project Coordinates	
Northing	169392.9109
Easting	546411.9966
Date	5/18/04

I hereby certify that this United States public land survey monument record is correct and complete to the best of my knowledge and belief.

*Larry D. Hoium* Date 7/20/15

Larry D. Hoium, Anoka County Surveyor  
Minnesota License Number 18165