

# CERTIFICATE OF LOCATION OF GOVERNMENT CORNER

County of Anoka


State of Minnesota

N<sup>1</sup>/<sub>16</sub><sup>th</sup> OF THE NW<sup>1</sup>/<sub>4</sub> Corner of Sec. 31 Township 32 Range 22

I hereby certify that on the 4<sup>th</sup> day of NOVEMBER, 1975, I found the described corner which was evidenced by CONCRETE MONUMENT

and I further certify that to perpetuate the location of said corner, I did, at the exact location thereof, place a permanent marker consisting of CONCRETE MONUMENT WITH SIGN & POST ON NORTH SIDE.

which reference or witness monuments are located in the manner following:

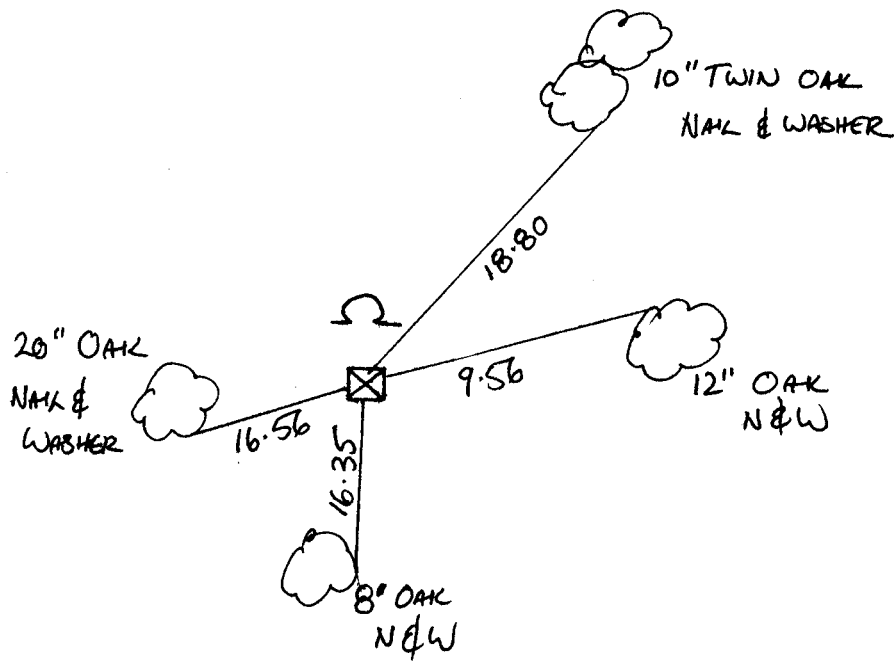

Revised date	Revised date	Revised date
7-16-90		
2-11-94		

