

CERTIFICATE OF LOCATION OF GOVERNMENT CORNER

County of Anoka

State of Minnesota



West 1/4 Corner of Sec. 29 Township 32 Range 22

On the 26th day of February, 2009, the described corner was evidenced by a 4"± X 4"± wood post down 0.5'± described in survey notes by E.G. Maxwell dated 1915

and to perpetuate the location of said corner, at the exact location thereof, a permanent marker was placed consisting of the same wood post with a P.K. nail in the center and a sign and post on the north side

AND on the ___ day of _____, _____, said permanent marker was _____

Updated reference ties are as shown below.

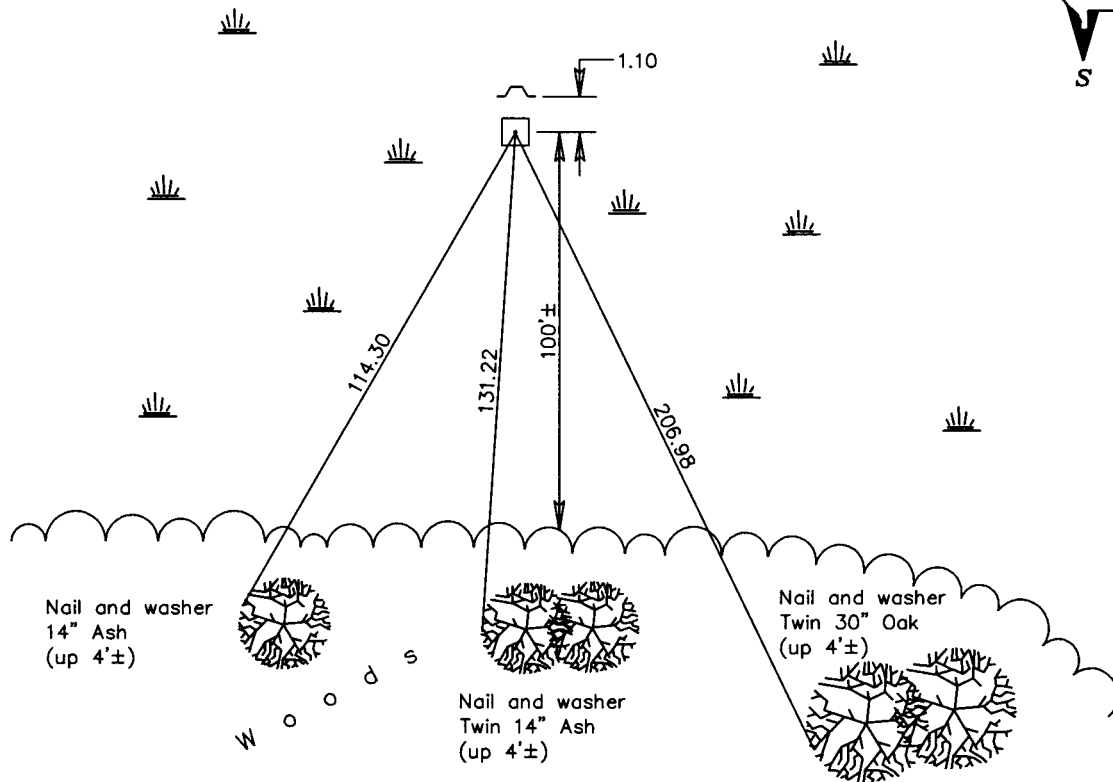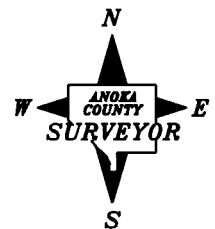

Revised date

2/26/09

N.A.D. 1983 Coordinates
(1996 Adjustment)

County Project Coordinates

Northing 172005.7820

Easting 537365.1500

Date 2/26/09

I hereby certify that this United States public land survey monument record is correct and complete to the best of my knowledge and belief.

Larry D. Hoium Date 2/26/09

Larry D. Hoium, Anoka County Surveyor

Minnesota License Number 18165