

CERTIFICATE OF LOCATION OF GOVERNMENT CORNER

County of Anoka

State of Minnesota



North 1/4 Corner of Sec. 2 Township 33 Range 22

On the 13th day of November, 1975, the described corner was evidenced by area resurvey

and to perpetuate the location of said corner, at the exact location thereof, a permanent marker was placed consisting of a cast iron monument

AND on the 22nd day of November, 2013, said permanent marker was found down 2'± and the ties were updated

Updated reference ties are as shown below.

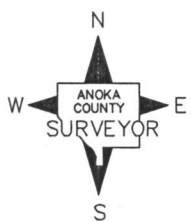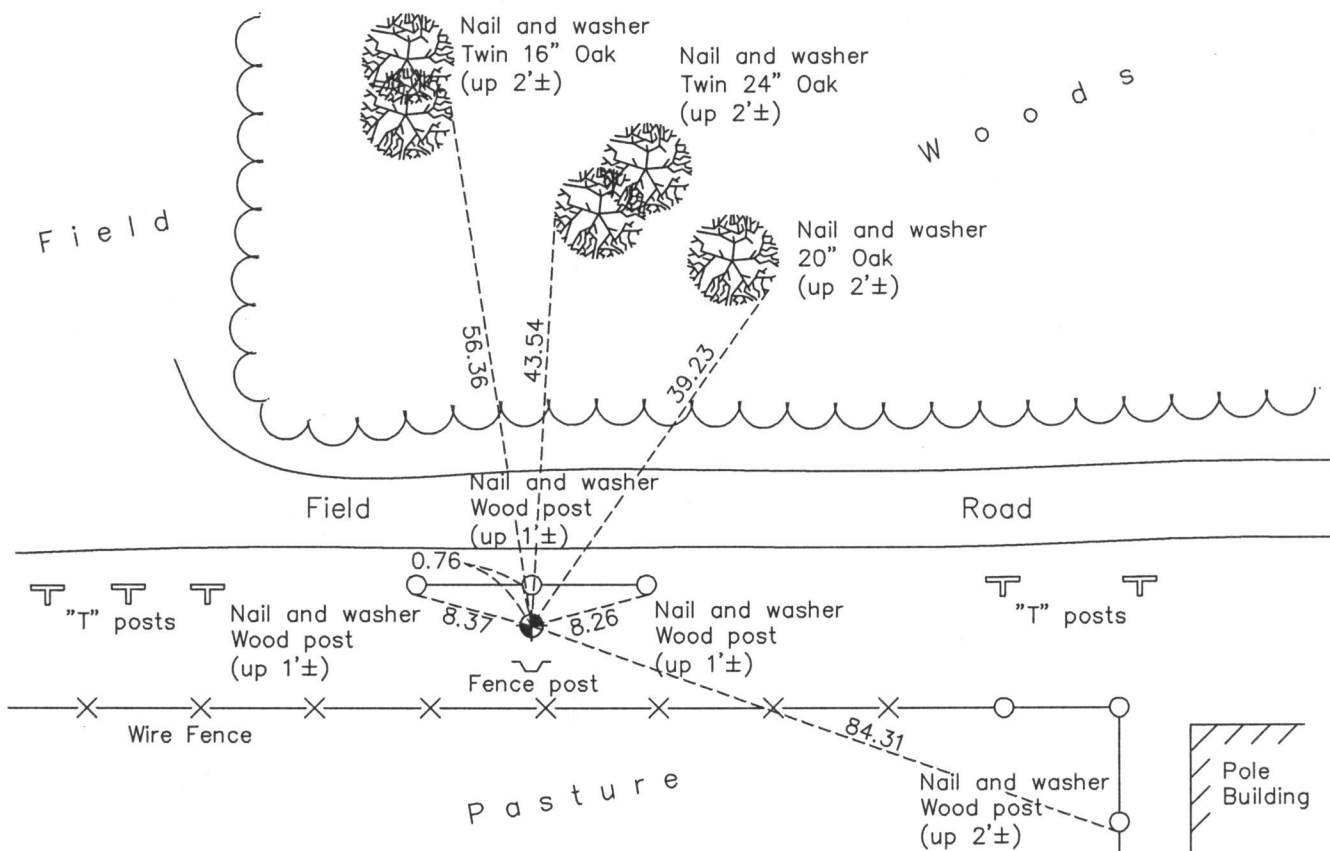

Revision Date

8/06/15

N.A.D. 1983 Coordinates
(1996 Adjustment)

County Project Coordinates	
Northing	226955.4594
Easting	555925.7146
Date	5/06/04

I hereby certify that this United States public land survey monument record is correct and complete to the best of my knowledge and belief.

Date 8/06/15

Larry D. Hoium, Anoka County Surveyor
 Minnesota License Number 18165