## CERTIFICATE OF LOCATION OF GOVERNMENT CORNER

County of Anoka


State of Minnesota

## West 1/4 Corner of Sec. 4 Township 33 Range 22

On the <u>13th</u> day of <u>May</u>, <u>1964</u>, the described corner was evidenced by <u>area resurvey</u>
and to perpetuate the location of said corner, at the exact location thereof, a permanent marker was placed consisting of <u>a cast iron monument</u>

AND on the <u>19th</u> day of <u>November</u>, <u>2013</u>, said permanent marker was <u>found and the ties</u>
were updated

Updated reference ties are as shown below.

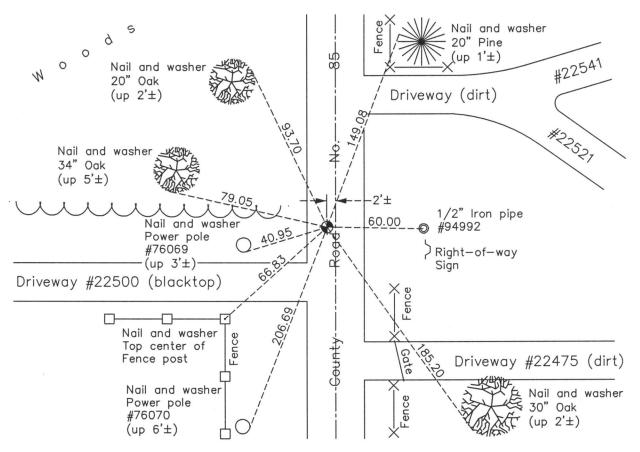



8/14/15

N.A.D. 1983 Coordinates (1996 Adjustment)

County P	roject Coordinates
Northing	224849.9226
Easting	542578.1862
Date	4/06/04

I hereby certify that this United States public land survey monument record is correct and complete to the best of my knowledge and belief.

Date 8/14/15

Larry D. Hoium , Anoka County Surveyor Minnesota License Number \_\_\_\_\_\_18165