

CERTIFICATE OF LOCATION OF GOVERNMENT CORNER

County of Anoka

State of Minnesota



West 1/4 Corner of Sec. 2 Township 33 Range 22

On the 28th day of February, 1977, the described corner was evidenced by area resurvey

and to perpetuate the location of said corner, at the exact location thereof, a permanent marker was placed consisting of a 2" red and white iron pipe

AND on the 19th day of December, 2013, said permanent marker was found up 4'± and leaning southerly 0.4'±. Red and white paint is worn off. The ties were updated.

Updated reference ties are as shown below.

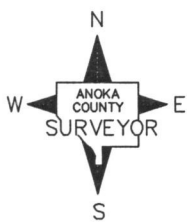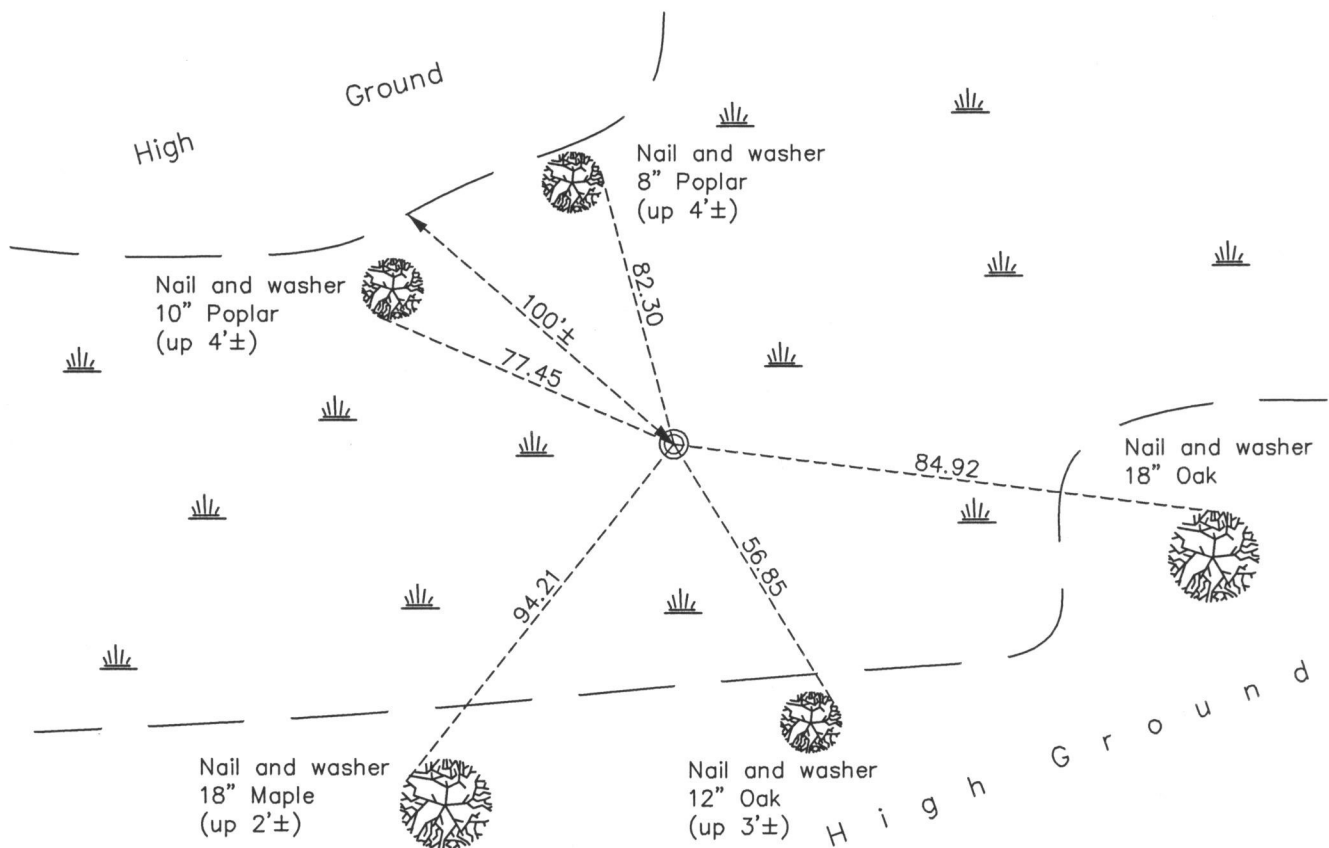

Revision Date

8/17/15

N.A.D. 1983 Coordinates
(1996 Adjustment)

County Project Coordinates	
Northing	<u>224749.9425</u>
Easting	<u>553213.7700</u>
Date	<u>2/22/05</u>

I hereby certify that this United States public land survey monument record is correct and complete to the best of my knowledge and belief.

Larry D. Hoium Date 8/17/15

Larry D. Hoium, Anoka County Surveyor

Minnesota License Number 18165